

REQUEST FOR INFORMATION (RFI)

PROJECT :	BKK2	R.F.I. NO. :	523213-01-RFI-AR-0040
TO :	CTA	ATTENTION :	CTA
SUBMITTED DATE:	4-Feb-26	NEED REPLY BY DATE :	11-Feb-26

SUBMISSION OF : ☒ Q&A ☒ Drawing ☐ Document ☐ Others (as specified below)

SUBJECT : Request for Information - Confirm to install Ceiling Side Guard 2nd to 5th FL

Total Page (s) : 2 (Including this page)

FUNCTION :	<input type="checkbox"/> Structural (ST)	<input type="checkbox"/> Electrical & Communication (EL)	<input type="checkbox"/> Mechanical (ME)	<input type="checkbox"/> Vertical Transport (VT)
	<input checked="" type="checkbox"/> Architectural (AR)	<input type="checkbox"/> Fire Protection (FI)	<input type="checkbox"/> Hydraulic & Sanitary (HY)	<input type="checkbox"/> Other (O)

(1) CONTRACTOR REQUEST FOR INFORMATION :

Please confirm for the Ceiling Side Guard as shown in the drawing for Data Hall 2nd to 5th FL.

Requested by : 
Engineering Manager


Reviewed by : 
Project Manager

(2) ATTN : Commtech Asia (Thailand)

☐ For Approval ☐ See Note ☒ Please Clarify

Note : Please Aurecon clarify and confirm for the Ceiling Side Guard as shown in the drawing for Data Hall 2nd to 5th FL.

From : GAA Group

By : 
Name / Position : Mr. Itsarate Trachuengtong/
Project Manager

Date : 4-Feb-26

Reviewed By : Commtech Asia (Thailand)

Name / Position : Aphisakda Phueakchanthuek
Construction Engineer

Date : 2/6/2026

(3) ATTN : AURECON

☐ For Approval ☐ See Note ☐ Please Clarify

Note : SLA: Make corrections as noted and proceed.

From : Commtech Asia (Thailand)

By : 
Name / Position : (Aphisakda Phueakchanthuek)
Construction Engineer

Date : 2/6/2026

Reviewed By : Tarkoon Suwansukhum
AURECON

Name / Position : (Tarkoon S / Architect)

Date : 9 February 2026

(4) ATTN : STT GDC

☐ Clarification only ☐ Not Approved
☐ Approved for proceeding work
☐ Approved with comments, proceeding work in compliance with comments
☐ Approved with comments, not for proceeding work and need to re-submit

Note :

From : AURECON

By :


Name / Position : ()

Date :

Reviewed By : STT GDC

Name / Position

Date :

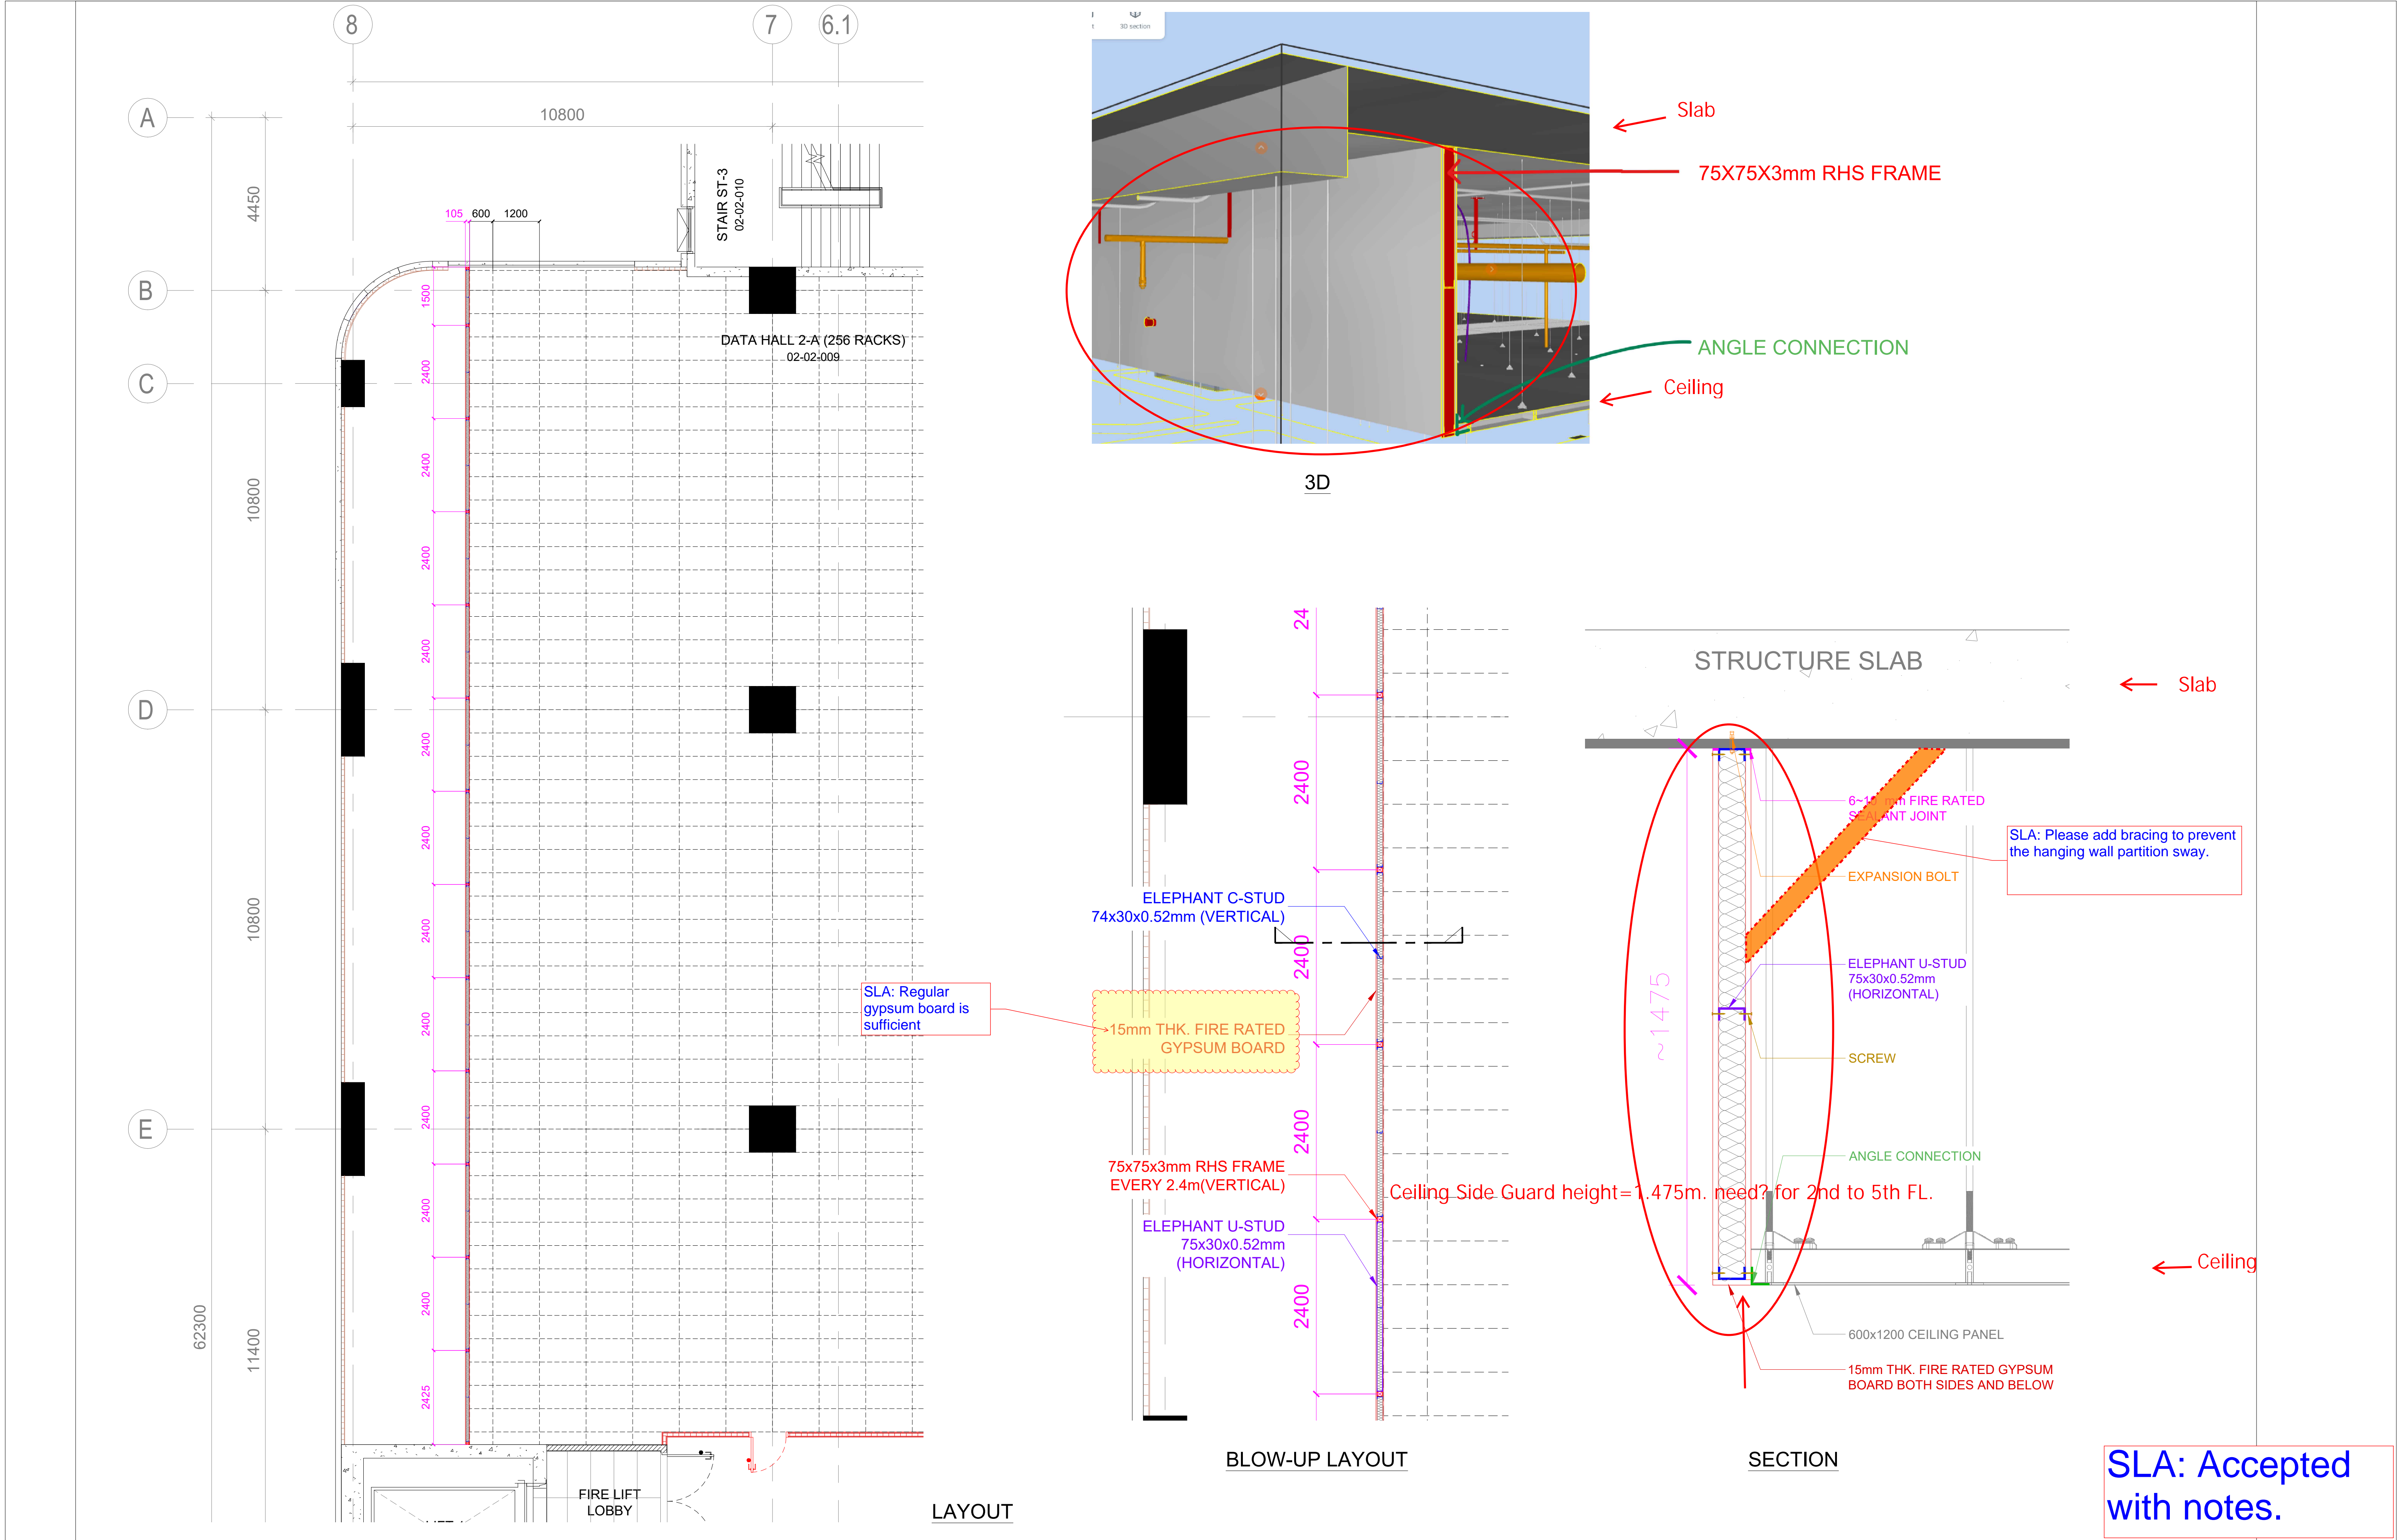

REV.	REVISION DESCRIPTION	DATE	ISSUED BY	OWNER :	CONSULTANT :	CONTRACTOR :	PROJECT TITLE :	DRAWN BY :	DATE DRAWN :	SHOP DRAWING NO. :	REV. NO. :
				<div>STTelemedia Global Data Centres</div> <div>NO. 944 MITRTOWN OFFICE TOWER, 22ND FLOOR, RAMA 4 ROAD, WANGMAI SUBDISTRICT, PATHUMWAN DISTRICT, BANGKOK 10330, THAILAND</div>	<div>cta COMMTECH ASIA</div> <div>999/9 The Office at Central World, 38th Floor, Suite No.3805, Rama 1 Rd., Pathumwan, Bangkok 10330</div>	<div>Gaa Group Company Limited</div> <div>120 Ample Tower Floor 11 Room 8 Bangna-Trad Rd., Bangna Nuea, Bangkok 10250</div>	<div>PROJECT TERRA NORTH (BKK-02)</div> <div>DRAWING TITLE : PROPOSED CEILING COVER DETAIL</div>	TS	04 FEB 26	523213-02-SDW-AR-0XXX	0
								CHECKED BY :	DATE ISSUE :	REFERENCE DRAWING NO. :	REV. NO. :
								APPROVE BY :	04 FEB 26	523213-02-DRG-AR-XXXX	0
									SCALE :	RFAS NO. :	REV. NO. :
									AS SHOWN - A1	523213_02_RFAS_AR_XXXX	0