

REQUEST FOR INFORMATION (RFI)

PROJECT :	BKK2	R.F.I. NO. :	523213-01-RFI-AR-0029
TO :	CTA	ATTENTION :	CTA
SUBMITTED DATE:	20-Jan-26	NEED REPLY BY DATE :	27-Jan-26

SUBMISSION OF : ☒ Q&A ☒ Drawing ☒ Document ☐ Others (as specified below)

SUBJECT : Request for Information - Confirm Colour for Partition Wall Toilet Room 1st to 5th Floor

Total Page (s) : 8 (Including this page)

FUNCTION : ☐ Structural (ST) ☐ Electrical & Communication (EL) ☐ Mechanical (ME) ☐ Vertical Transport (VT)
☒ Achitectoral (AR) ☐ Fire Protection (FI) ☐ Hydraulic & Sanitary (HY) ☐ Other (O)

(1) CONTRACTOR REQUEST FOR INFORMATION :

GAA need to confirm information about wall partition by Willy. Which color do we need to apply in partition wall because in Aurecon's drawing did not shown any details about this.

Requested by :

Engineering Manager

Reviewed by :

Project Manager

(2) ATTN : Commtech Asia (Thailand)		From :	GAA Group
<input type="checkbox"/>	For Approval	<input type="checkbox"/>	See Note
		<input checked="" type="checkbox"/>	Please Clarify

Note :

Aurecon to confirm the colour of the wall partition for the toilet room from level 1 to level 5.

By :

20081820

Name / Position

Mr. Itsarate Trachuengtong/
Project Manager

Date :

20-Jan-26

Reviewed By :

20081820


Name / Position


Finlay Coady
Sr. Project Manager

Date :

30th January 2026


(3) ATTN : AURECON		From :	Commtech Asia (Thailand)
<input type="checkbox"/>	For Approval	By :	
<input type="checkbox"/>	See Note	Name / Position	()
<input type="checkbox"/>	Please Clarify	Date :	
Note :		Reviewed By :	Tarkoon Suwansukhum
			AURECON
		Name / Position	(Tarkoon S / Architect)
		Date :	3 February 2026

(4) ATTN : STT GDC		From :	AURECON
<input checked="" type="checkbox"/>	Clarification only	By :	
<input type="checkbox"/>	Not Approved	Name / Position	()
<input type="checkbox"/>	Approved for proceeding work	Date :	
<input type="checkbox"/>	Approved with comments, proceeding work in compliance with comments		
<input type="checkbox"/>	Approved with comments, not for proceeding work and need to re-submit		
Note :		Reviewed By :	STT GDC 
Please follow with SLA's response.		Name / Position	Sirawit Thepsuwan VP PMO
		Date :	6 Feb 2026

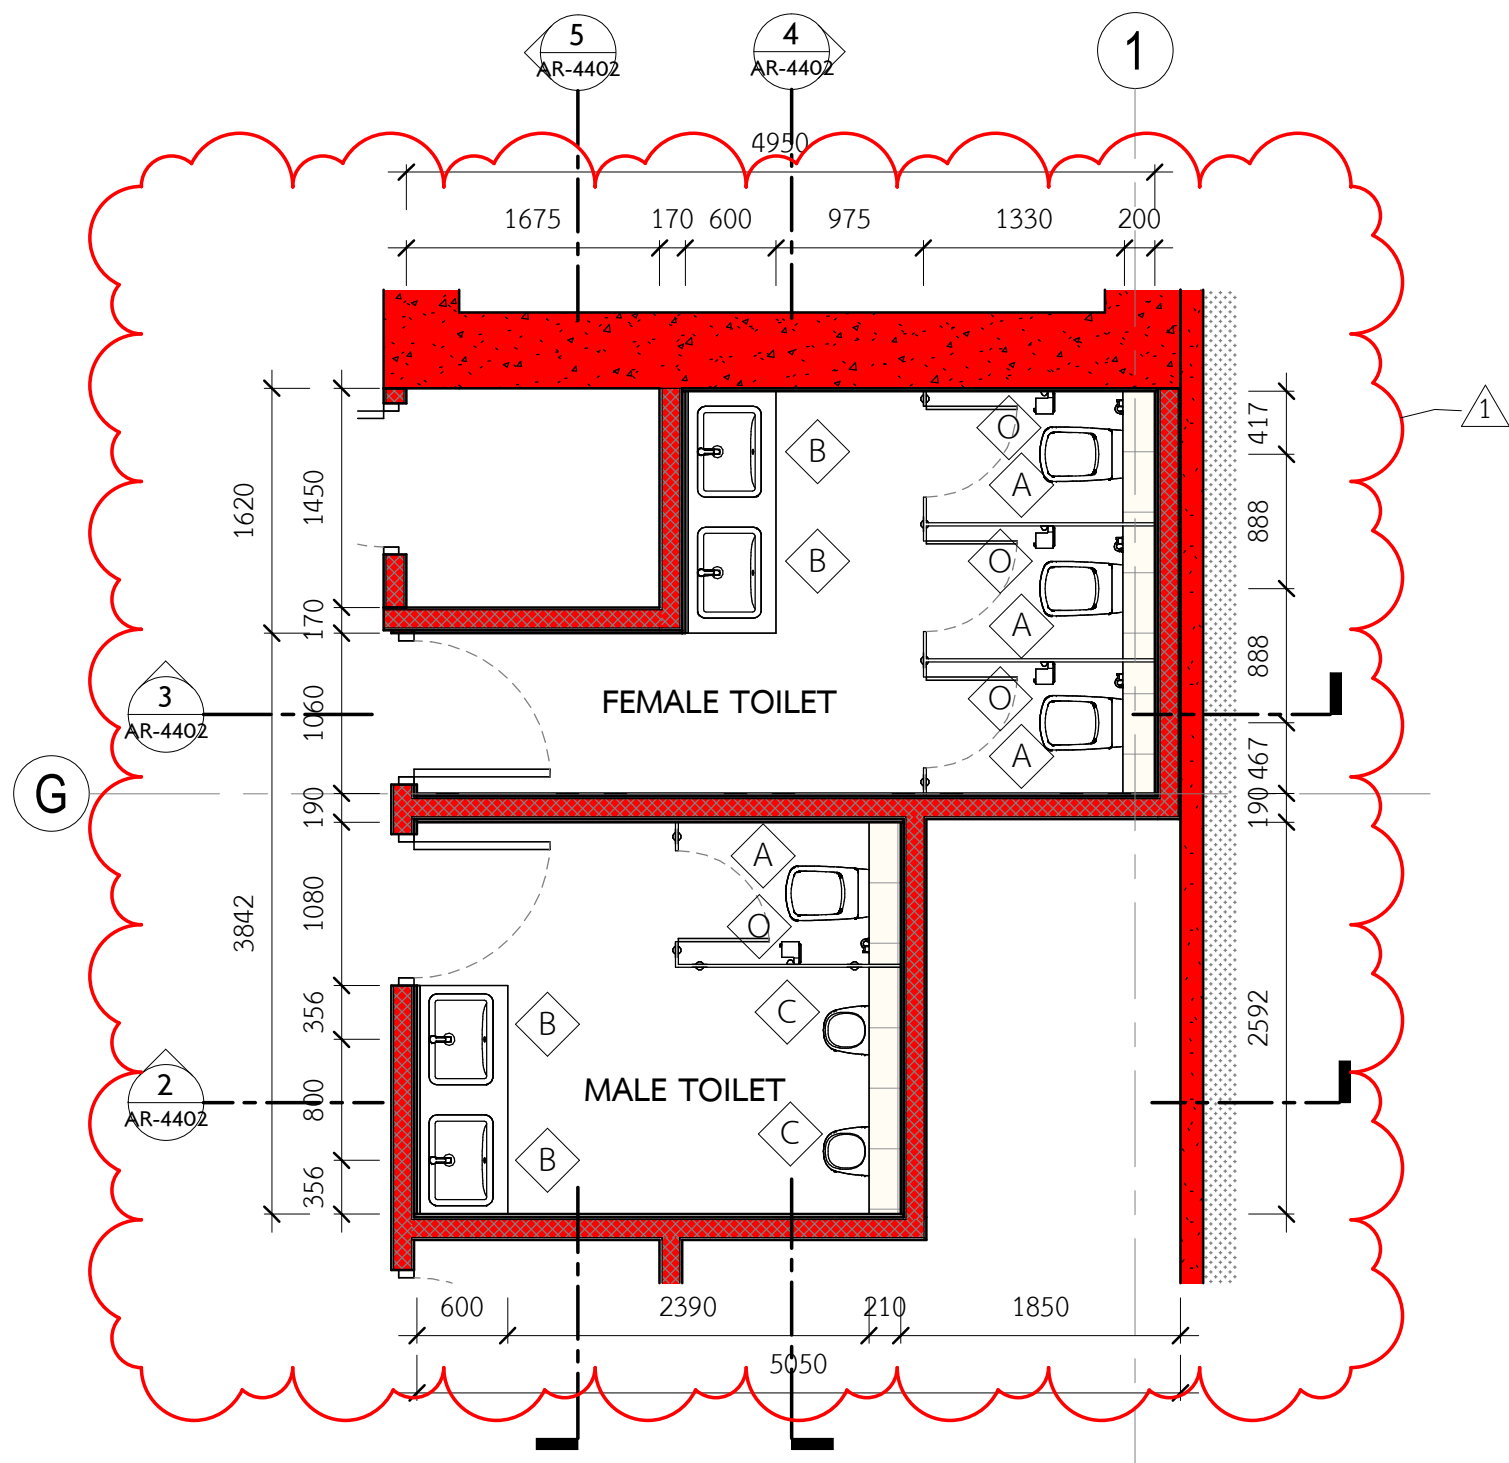


MALE&FEMALE TOILET 1st FLOOR PLAN

SCALE 1 : 50

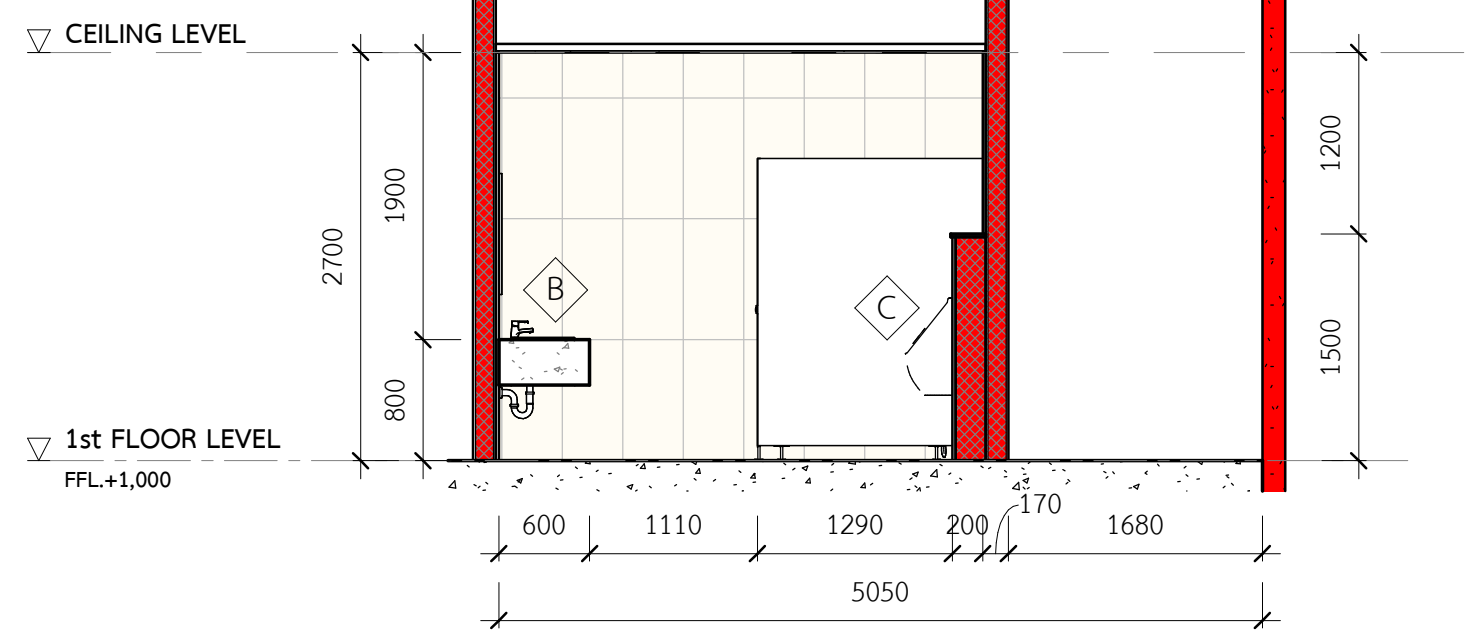


MALE&FEMALE TOILET ELEVATION 1

SCALE 1 : 50

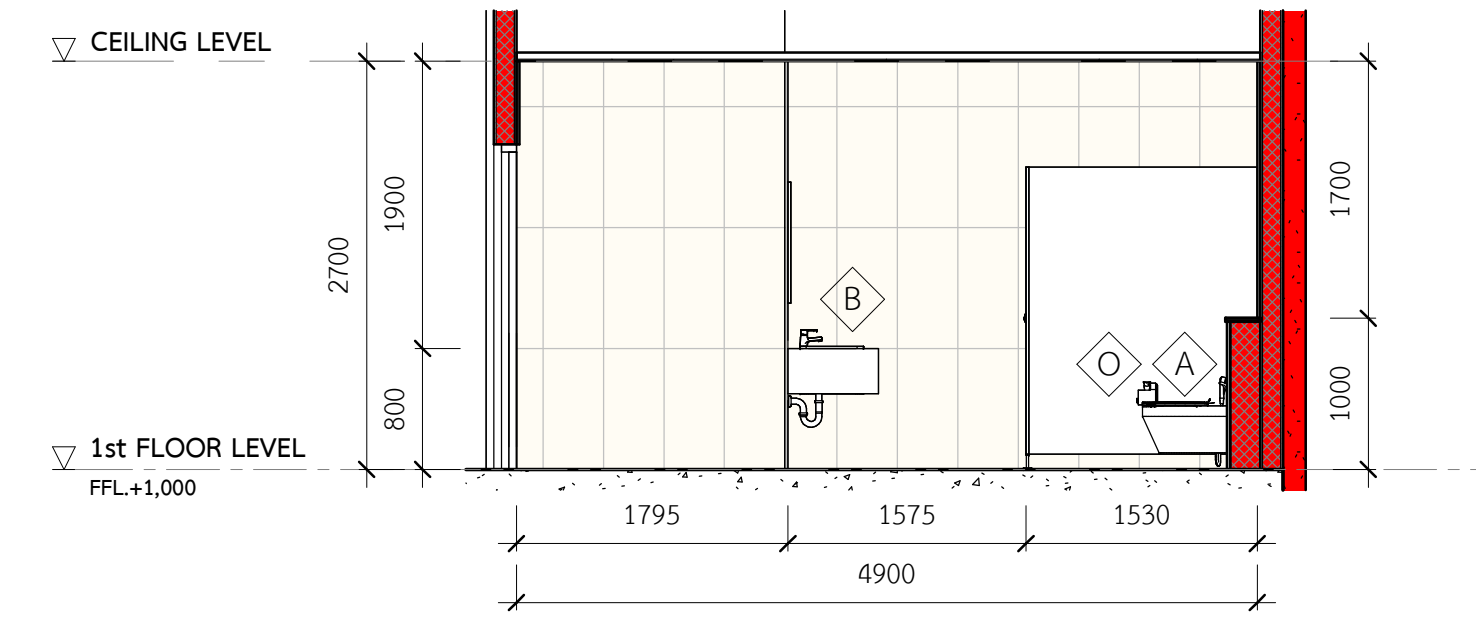


MALE&FEMALE TOILET ELEVATION 2

SCALE 1 : 50

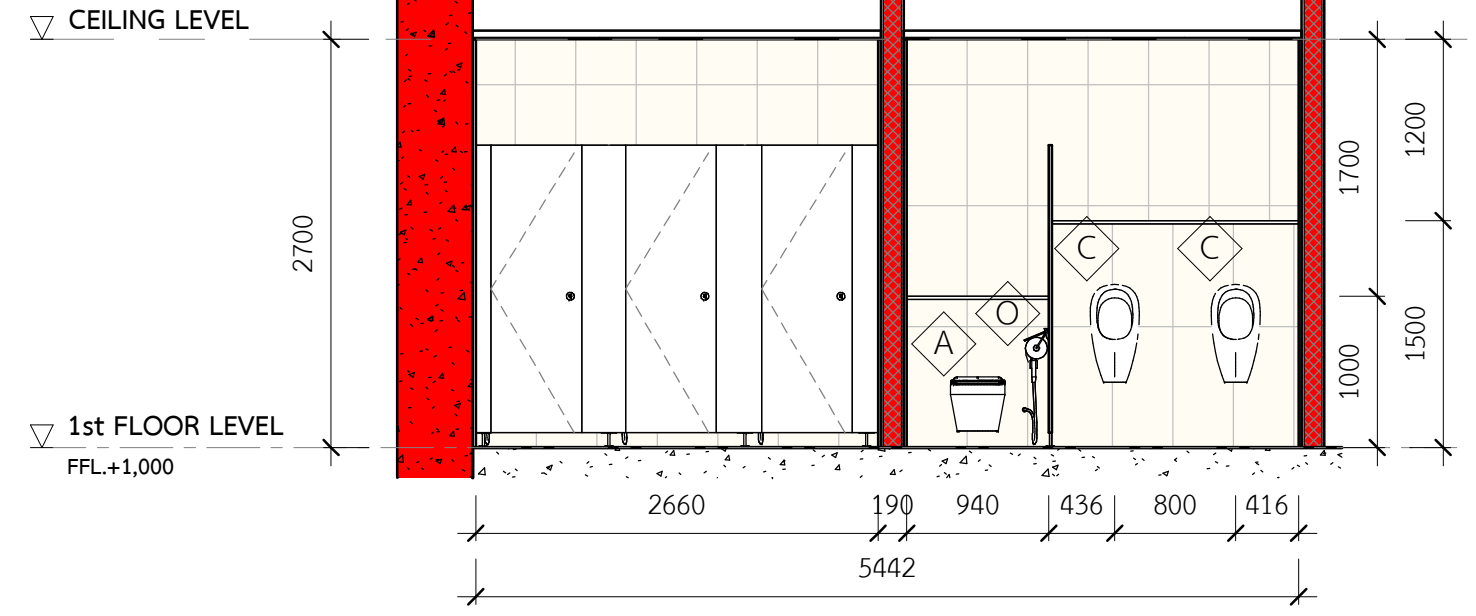

MALE&FEMALE TOILET ELEVATION 3



SCALE 1 : 50

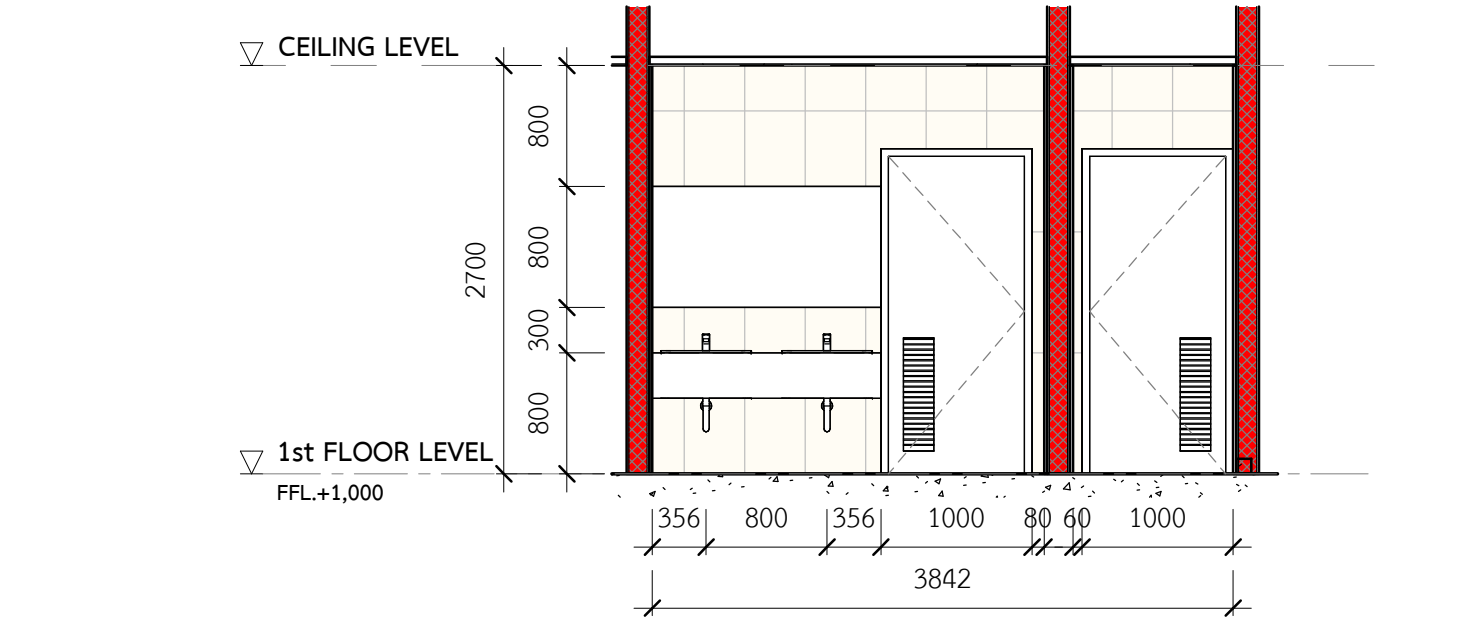

MALE&FEMALE TOILET ELEVATION 4


SCALE 1 : 50

STANDARD FOR HANDICAPED HARDWARE & BATHWARE INSTALLATION DETAIL

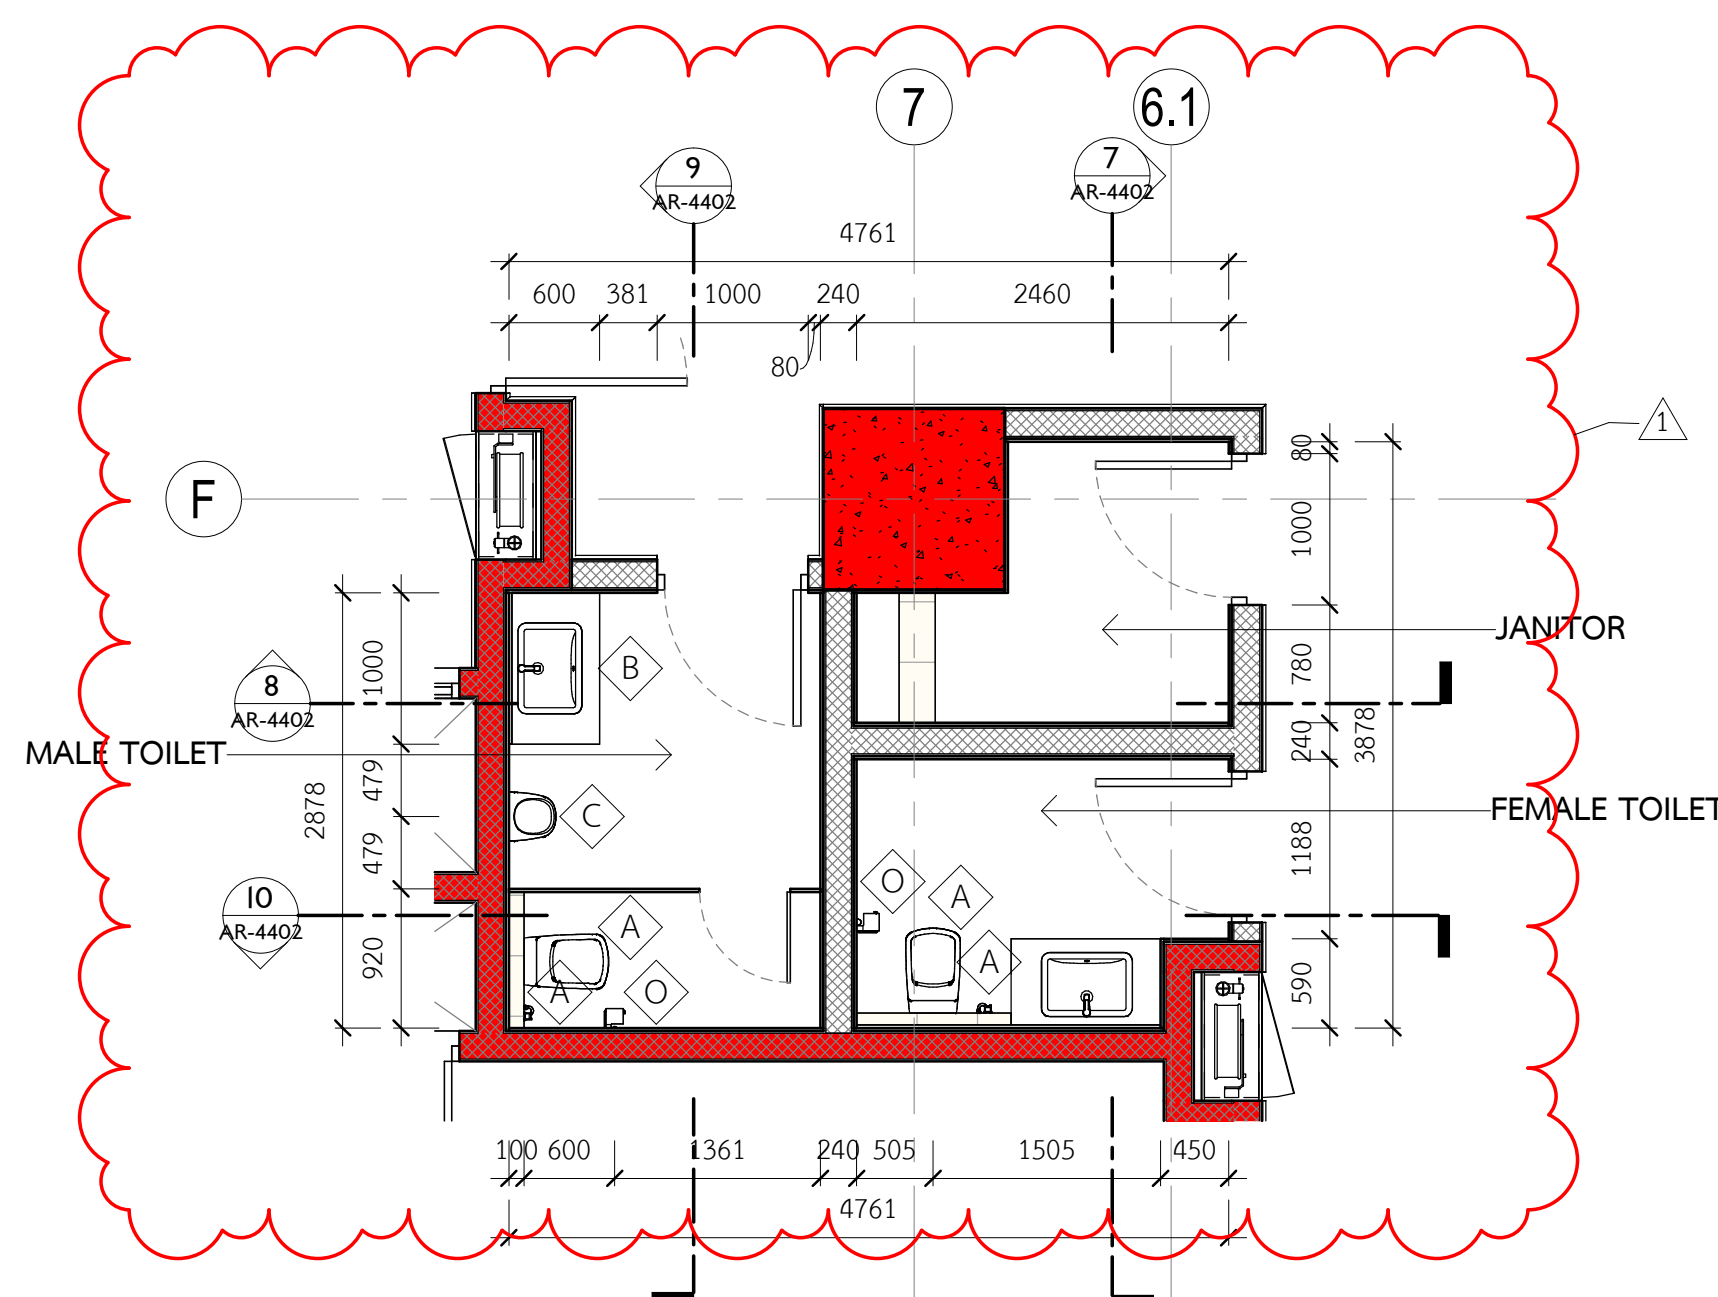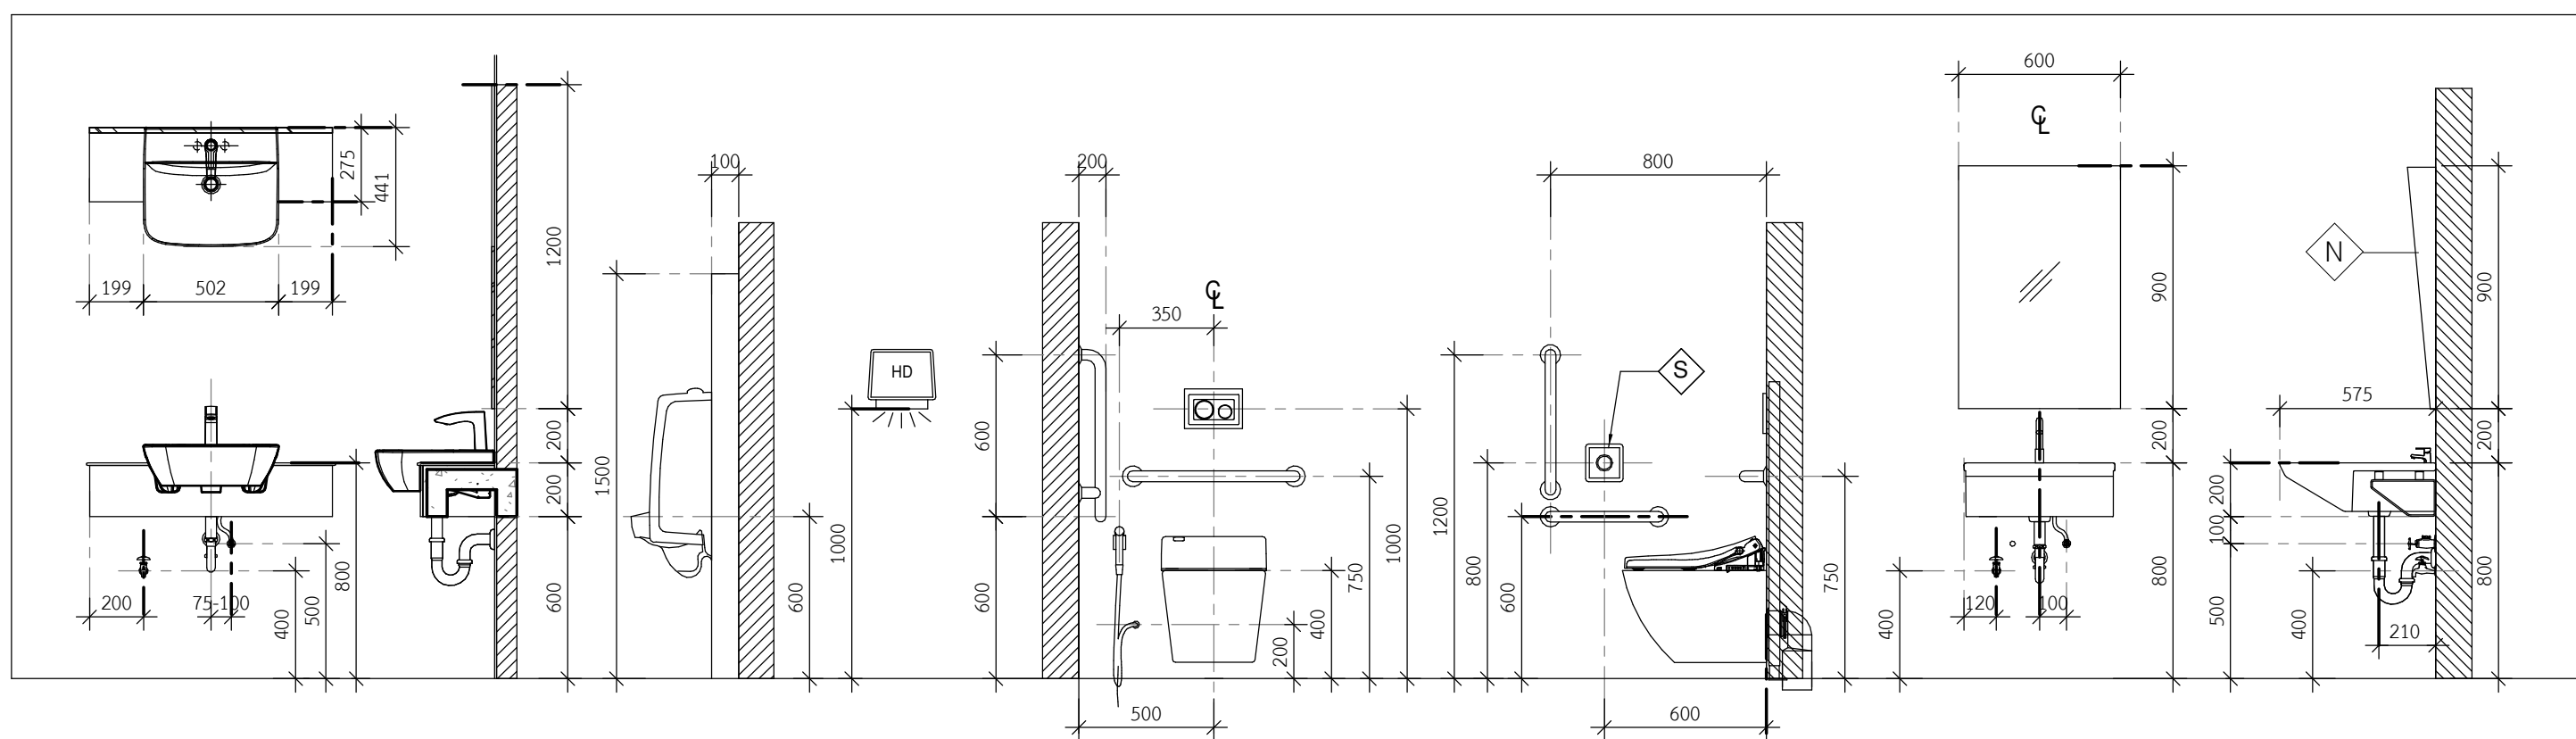


MALE&FEMALE TOILET 2nd-5th FLOOR PLAN

SCALE 1 : 50

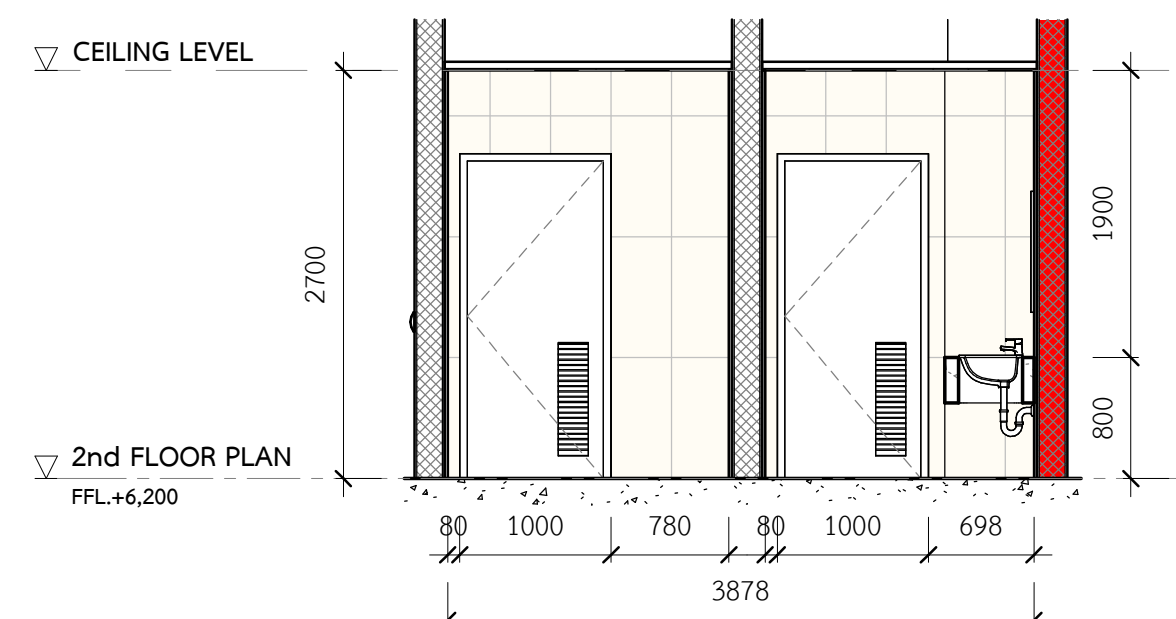


MALE&FEMALE TOILET 2nd-5th ELEVATION 1

SCALE 1 : 50

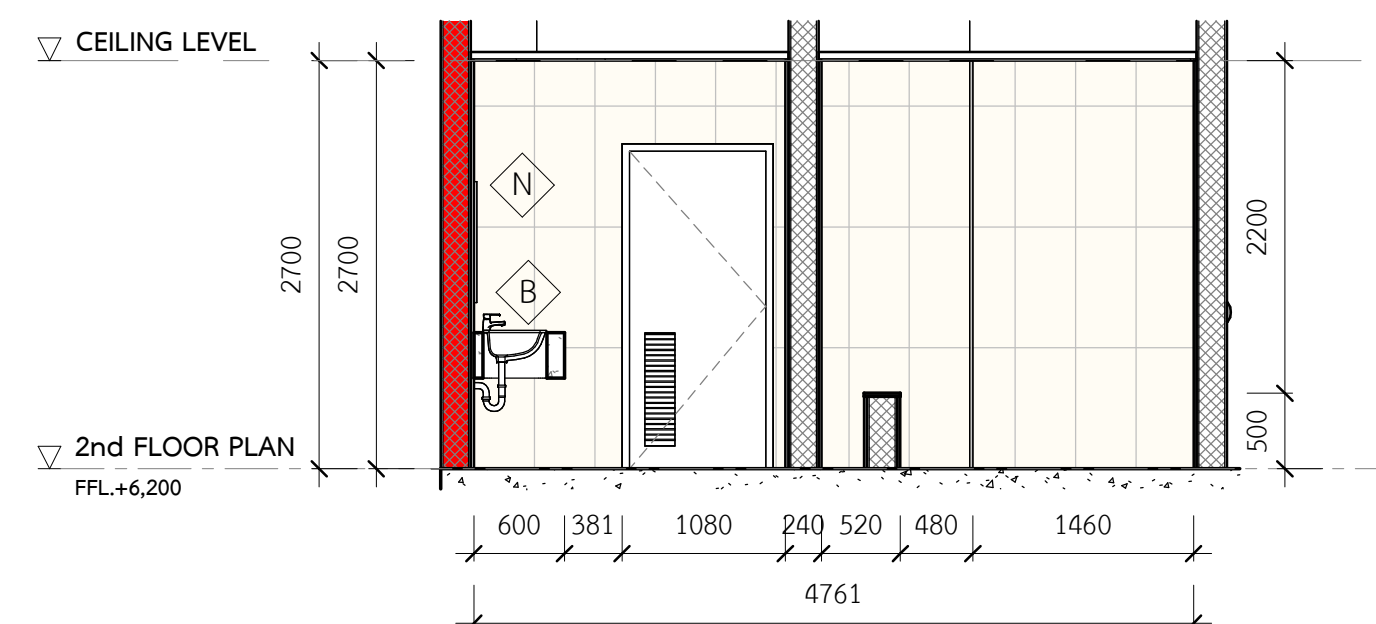


MALE&FEMALE TOILET 2nd-5th ELEVATION 2

SCALE 1 : 50

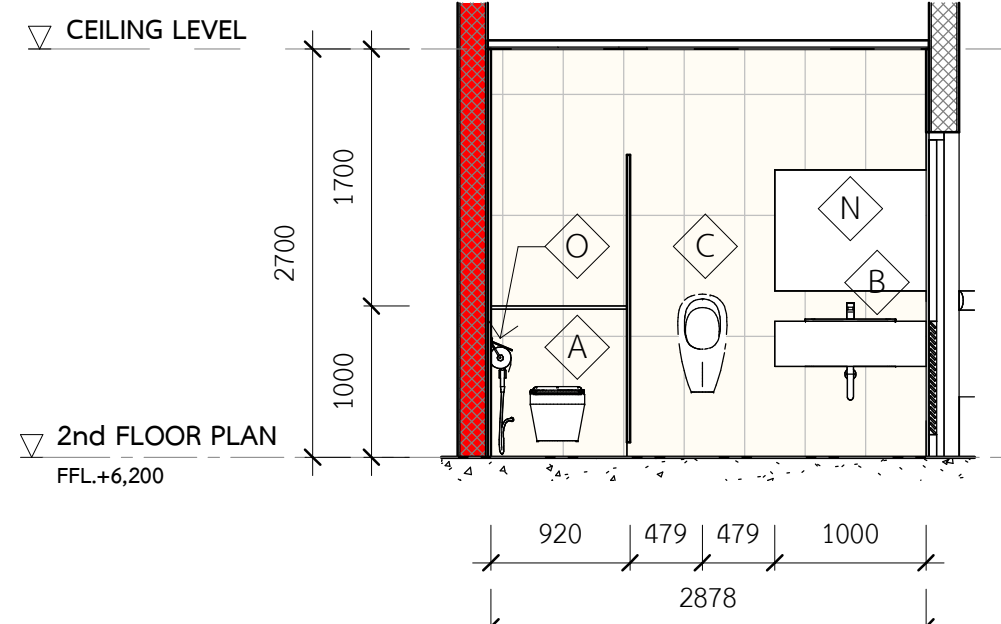

MALE&FEMALE TOILET 2nd-5th ELEVATION 3


SCALE 1 : 50

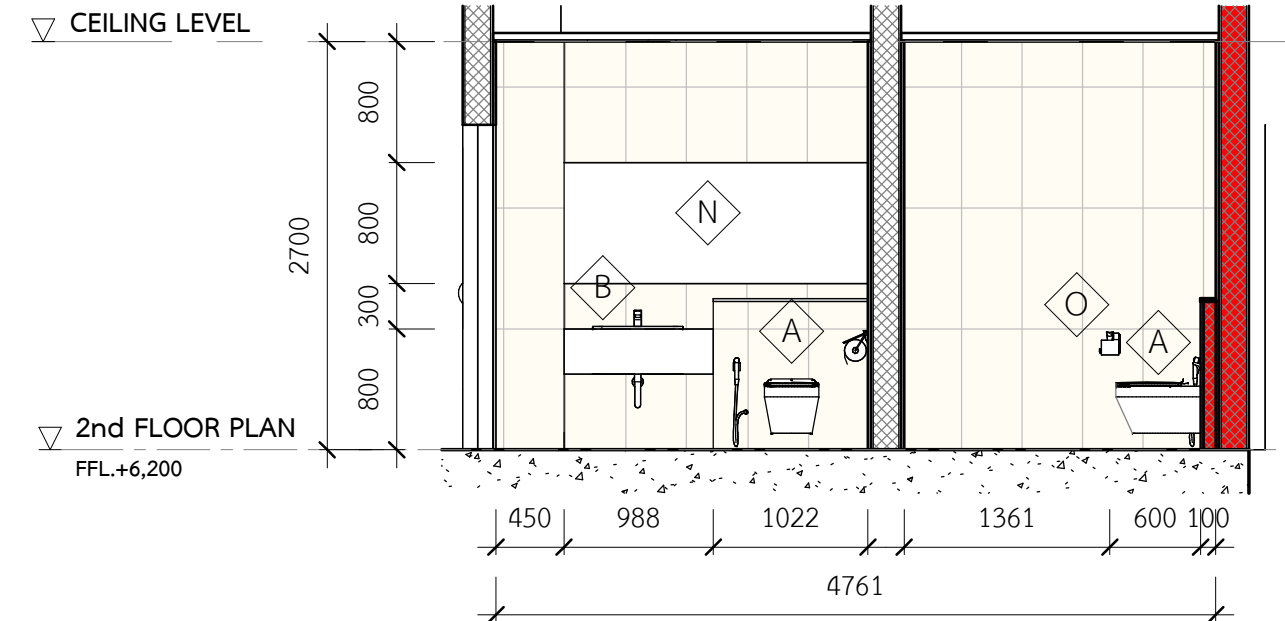

MALE&FEMALE TOILET 2nd-5th ELEVATION 4

SCALE 1 : 50

STANDARD FOR HARDWARE & BATHWARE INSTALLATION DETAIL

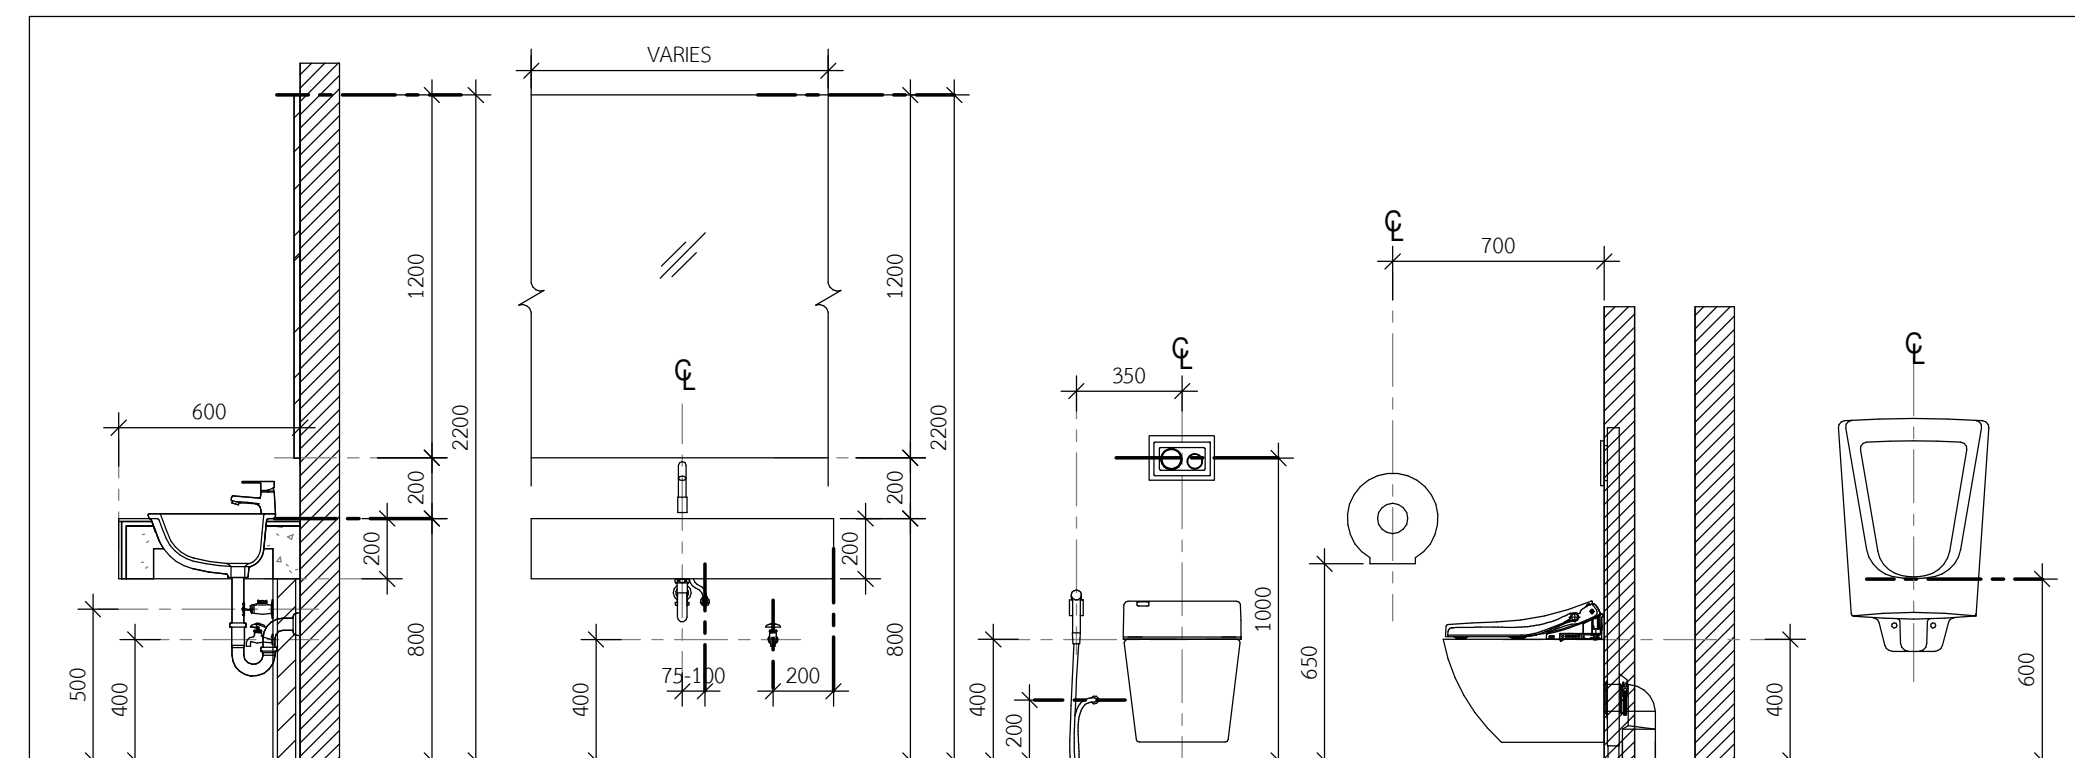

NOTE :

1. WALL BETWEEN TOILET TO OTHER ROOM SHALL BE UP TO UNDERSIDE OF ABOVE SLAB
2. WALL BETWEEN TOILET TO OTHER ROOM SHALL BE 150 MM. HIGH ABOVE SUSPENDED CEILING

รายการอุปกรณ์ห้องน้ำ BATHWARE SCHEDULE		
NO.	DESCRIPTION	SUPPLIER
A	WATER CLOSET WALL HUNG TYPE : 3119-WT-0 WASTE PIPE : VP-3815, BRACKET VP-955032, STOP VALVE : A-5601 SENSOR FLOW CONCEALED TOILET FLUSH VALVE : A-8613-000-50, OUTLET SPUD FOR PIPE : A-8603-000-50, HYGIENIC SPRAY : A-4700A-CH	BY AMERICAN STANDARD OR APPROVED EQUAL
B	WASH HAND BASIN CONCEALED COUNTER TOP : WP-F513-WT, SENSOR FAUCET : A-8506-AC, FLEXIBLE SUPPLY HOSE : A-800-16-DIY, P-TRAP : A-8108-DIY, WASTE OUTLET : A-8009, STOP VALVE : A-5601	BY AMERICAN STANDARD OR APPROVED EQUAL
C	URINAL : CCAS6519-3120410F0 WITH SENSOR	BY AMERICAN STANDARD OR APPROVED EQUAL
D	WATER CLOSET : TF-3229P-WT WASTE PIPE : VP-3815, BRACKET VP-955032, STOP VALVE : A-5601, SENSOR FLOW CONCEALED TOILET FLUSH VALVE : A-8613-000-50, OUTLET SPUD FOR PIPE : A-8603-000-50, HYGIENIC SPRAY : A-4700A-CH	BY AMERICAN STANDARD OR APPROVED EQUAL
E	WHEEL CHAIR BASIN : COTTO SC00537 SENSOR FAUCET : A-8506-AC, FLEXIBLE SUPPLY HOSE : A-800-16-DIY, P-TRAP : A-8108-DIY, WASTE OUTLET : A-8009, STOP VALVE : A-5601	BY COTTO AND AMERICAN STANDARD OR APPROVED EQUAL
F	WALL MOUNTED SWING UP GRAB BAR B-4998	BY BOBRICK OR APPROVED EQUAL
G	STRAIGHT GRAB BAR : HORIZONTAL B-5806x36, B-5806x42 AND VERTICAL B-5806x18	BY BOBRICK OR APPROVED EQUAL
H	F40017-CHADY RAIN CLICK PUSH BUTTON SHOWER SET	BY AMERICAN STANDARD OR APPROVED EQUAL
I	MIRROR : 6 MM THK. MIRROR 1200 MM. HIGH X FULL LENGTH ON 4 MM THK. MOISTURE RESISTANT PLYWOOD WITH 20 MM. S/S FRAME	-
K	WALL TAP : FFAST602-0T0500BT0	BY AMERICAN STANDARD OR APPROVED EQUAL
L	SOAP HOLDER : B-26607	BY BOBRICK OR APPROVED EQUAL
M	FLOOR DRAIN : A-8204-N	BY AMERICAN STANDARD OR APPROVED EQUAL
N	TLT MIRROR : B-293 2436 610x910 MM.	BY BOBRICK OR APPROVED EQUAL
O	TOILET TISSUE DISPENSER : B-2890	BY BOBRICK OR APPROVED EQUAL
P	TOILET CUBICLE PARTITION : 13 HPL	BY WILLY OR APPROVED EQUAL
R	TOWEL BAR : K-1393-46 N	BY AMERICAN STANDARD OR APPROVED EQUAL
S	HAND DRYER : B-7128	BY BOBRICK OR APPROVED EQUAL
T	EMERGENCY TOILET CALL SYSTEM (EMERGENCY SWITCH AND CORRIDOR LIGHT)	EMERGENCY SWITCH ABB BUSCH-INFOINE-CALL SYSTEM OR APPROVED EQUAL
U	STEEL LOCKER 917W X 457D X 1829H LK-6109	BY LUCKY (SIAM STEEL)
V	MIRROR : 6 MM THK. MIRROR 600W X 1200H MM. WIDE X HIGH ON 4 MM THK. MOISTURE RESISTANT PLYWOOD WITH 20 MM. S/S FRAME	BY WILLY—(NOT-USE)—
W	TOILET CUBICLE PARTITION : 13 HPL WITH ALUMINIUM BASE EXCEPT DOOR	BY AMERICAN STANDARD OR APPROVED EQUAL
X	SEMI COUNTER WASH BASIN : 0518-WT—, SENSOR FAUCET : A-8506-AC, FLEXIBLE SUPPLY HOSE : A-800-16-DIY, P-TRAP : A-8108-DIY, WASTE OUTLET : A-8009—, STOP VALVE : A-5601—	BY AMERICAN STANDARD OR APPROVED EQUAL
Y	CYNET WALL HUNG BASIN : VP-1511-WT—, SENSOR FAUCET : A-8506-AC, FLEXIBLE SUPPLY HOSE : A-800-16-DIY, P-TRAP : A-8108-DIY, WASTE OUTLET : A-8009—, STOP VALVE : A-5601—	BY AMERICAN STANDARD OR APPROVED EQUAL

CLIENT
ST Telemedia
Global Data Centres
STT GDC (THAILAND) CO., LTD.
944 Mitotown Office Tower, 22nd-23rd Floor
Rama 4 Road, Wangmai, Pathumwan, Bangkok 10330

ENGINEER
aurecon
www.aurecongroup.com
AURECON CONSULTING (THAILAND) CO., LTD.
89 AA Capital Center Building, 21st Floor, Unit 2104-2107
Ratchadapisek Road, Din Daeng, Bangkok 10400

STRUCTURAL REVIEWER
สถาปนิก เจ้าพนักงาน
วันที่ 1754
STRUCTURAL
วิศวกร สถาปนิก
วันที่ 1488
วิศวกร สถาปนิก
วันที่ 9229
วิศวกร สถาปนิก
วันที่ 68414

ANITARY AND FIRE PROTECTION
วิศวกร สถาปนิก
วันที่ 209
วิศวกร สถาปนิก
วันที่ 438
วิศวกร สถาปนิก
วันที่ 3502
วิศวกร สถาปนิก
วันที่ 3907
วิศวกร สถาปนิก
วันที่ 4891
วิศวกร สถาปนิก
วันที่ 6969

ELECTRICAL AND COMMUNICATIONS
วิศวกร สถาปนิก
วันที่ 1297
วิศวกร สถาปนิก
วันที่ 6721
วิศวกร สถาปนิก
วันที่ 6847
วิศวกร สถาปนิก
วันที่ 53962
วิศวกร สถาปนิก
วันที่ 59400

MECHANICAL ENGINEER
วิศวกร สถาปนิก
วันที่ 848
วิศวกร สถาปนิก
วันที่ 4976
วิศวกร สถาปนิก
วันที่ 5005

ARCHITECTS
Steven Leach
Partners in creative solutions
STEVEN J. LEACH ARCHITECTS LIMITED
บริษัท สตีเวน เอ. ลีช อาร์ทคิเทค จำกัด
62 อาคารเฉลิมถรณ์ ชั้น 10 ซอยถนัดสวน ถนนพหลโยธิน
บางเขน กรุงเทพมหานคร 10330

ARCHITECT
สถาปนิก สถาปนิก
วันที่ 603
สถาปนิก สถาปนิก
วันที่ 3222

REV	DATE	DESCRIPTION	APP
1	12/08/25	100% DESIGN	TS
0	04/09/25	100% DESIGN	TS
SCALE	SIZE		
1 : 50	A0		
DRAWN	APPROVED		
CC	DATE		
DESIGNED	12/09/25		
SLA			
CHECKED			
TS			

PROJECT
อาคารพาณิชย์ 28 ชั้น 10 ซอยถนัดสวน ถนนพหลโยธิน
พื้นที่ 8 ชั้น จำนวน 1 หลัง
อาคารพาณิชย์ 28 ชั้น 10 ซอยถนัดสวน ถนนพหลโยธิน
บางเขน กรุงเทพมหานคร 10330

TITLE
TOILET ENLARGE ROOM DETAILS

DRAWING NUMBER
523213 - 02 - DRG - AR-4402



WILLY10HPL
WILLY13 HPL
HIGH PRESSURE LAMINATE



WILLY10HPL
WILLY13HPL
STAINLESS



* ภาพในแคตตาล็อกเป็นภาพสำหรับโฆษณาเท่านั้น



WILLY10HPL
WILLY13HPL
BLACK NYLON



* ภาพในแคตตาล็อกเป็นภาพสำหรับโฆษณาเท่านั้น




DIAGRAM

- (A) ALUMINIUM U-PROFILE
อลูมิเนียมตัว U
- (B) SIDE PILASTER
เสาข้าง
- (C) DOOR
ประตู
- (D) PILASTER
เสากลาง
- (E) ADJUSTABLE FOOTING
ขาตั้ง
- (F) TOP CHANNEL
บาร์บน

FEATURES

- (G) SPRING HINGE
บานพับสปริง
- (H) LOCK RIM BOLT WITH INDICATOR
กลอนพวงมีน๊อต

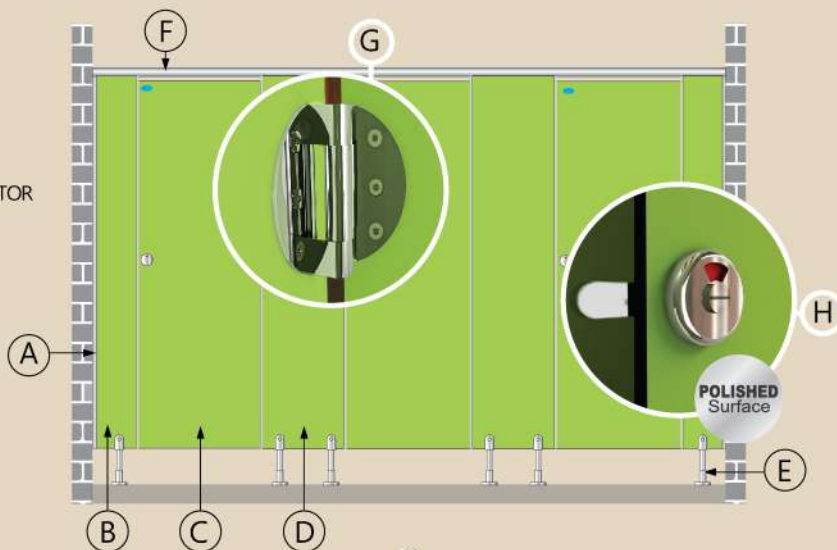

Coat hook
W-10 Code No: SC-1032 (P)
W-13 Code No: SC-1332 (P)
Surface: Polished



Lock rim bolt with indicator
W-10 Code No: SL-1024 (P)
W-13 Code No: SL-1324 (P)
Surface: Polished



Spring hinge
W-10 Code No: SH-1012 (P)
W-13 Code No: SH-1312 (P)
Surface: Polished



Tissue holder
W-10 Code No: ST-1041 (P)
W-13 Code No: ST-1341 (P)
Surface: Polished



D1



Adjustable footing
W-10 Code No: SF-1052 (P)
W-13 Code No: SF-1352 (P)
Surface: Polished



D2

Adjustable footing
W-10 Code No: SF-1053 (P)
W-13 Code No: SF-1353 (P)
Surface: Polished

DRAWING

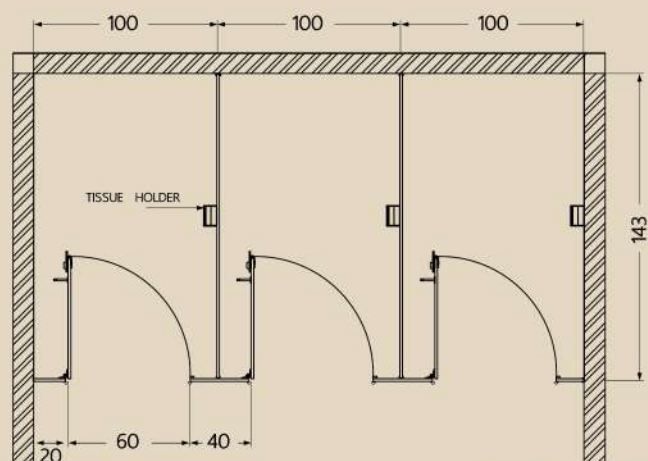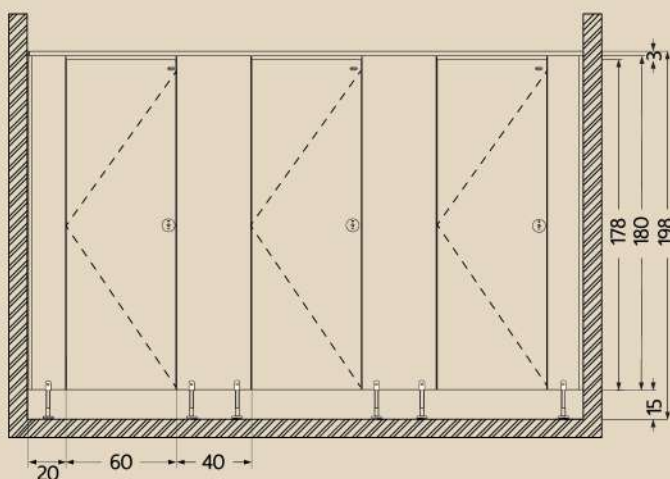


(unit : cm.)

DIAGRAM

- (A) ALUMINIUM U-PROFILE
อลูมิเนียมตัว U
- (B) SIDE PILASTER
เสาข้าง
- (C) DOOR
ประตู
- (D) PILASTER
เสากลาง
- (E) ADJUSTABLE FOOTING
ขาตั้ง
- (F) TOP CHANNEL
บาร์บน

FEATURES

- (G) BUTTERFLY HINGE
บานพับผีเสื้อ
- (H) LOCK RIM BOLT BLACK NYLON
กลอนทวน เนื้อไนลอน

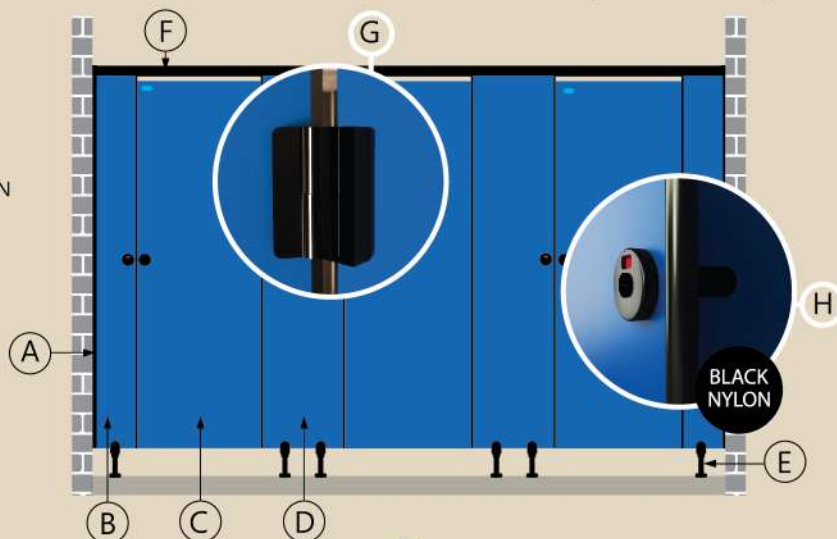

Coat hook
Code No: NCB-9031
Surface: Black nylon



Lock rim bolt
Code No: NLB-9021/2
Surface: Black nylon



Door handle
Code No: NKB-9081
Surface: Black nylon



Butterfly hinge
Code No: NHB-9011
Surface: Black nylon



Adjustable footing
W-10 Code No: NFB-9051
W-13 Code No: NFB-9052
Surface: Black nylon




Tissue holder
Code No: NTB-9042
Surface: Black nylon

รายละเอียด : Willy10mm13mm ประกอบด้วย ประตู แผ่นกลาง เสากลาง เสาข้างวัสดุทำจากแผ่น High pressure laminate หรือเรียกอีกชื่อว่า Compact laminate ขนาด 10 mm13mm.คุณสมบัติของแผ่น วัสดุคุณภาพ มาตรฐานเกรดพรีเมียม ทนน้ำ ทนกรดด่าง ทนขีดข่วน เนื้อแผ่นตรงกลางดีด้านนิ่มแผ่นวัสดุ ได้รับรองมาตรฐานการผลิต ทุกประเภทระดับสากลตามมาตรฐาน

ได้รับมาตรฐานการผลิตสากล : LPS08-H,ISO 4586-2 ISO 9001:2015 ISO 14001:2015 Green Industry Thailand Brand และ Thailand Trust Mark

construction : Willy 10mm 13mm HPL components Include Door panel, side panel front pillar and side pillar. the main material of the panel is made out of Premium grade ,10mm 13mm in thickness HPL (high pressure laminate) or relatively known as HPL Compact board. Special properties include : water resistant Acid and base resistant, scratch resistance Following International standard

Awarded International Standards : LPS08-ISO 4586-2 ISO 9001:2015 ISO 14001:2015 Green Industry Thailand Brand และ Thailand Trust Mark

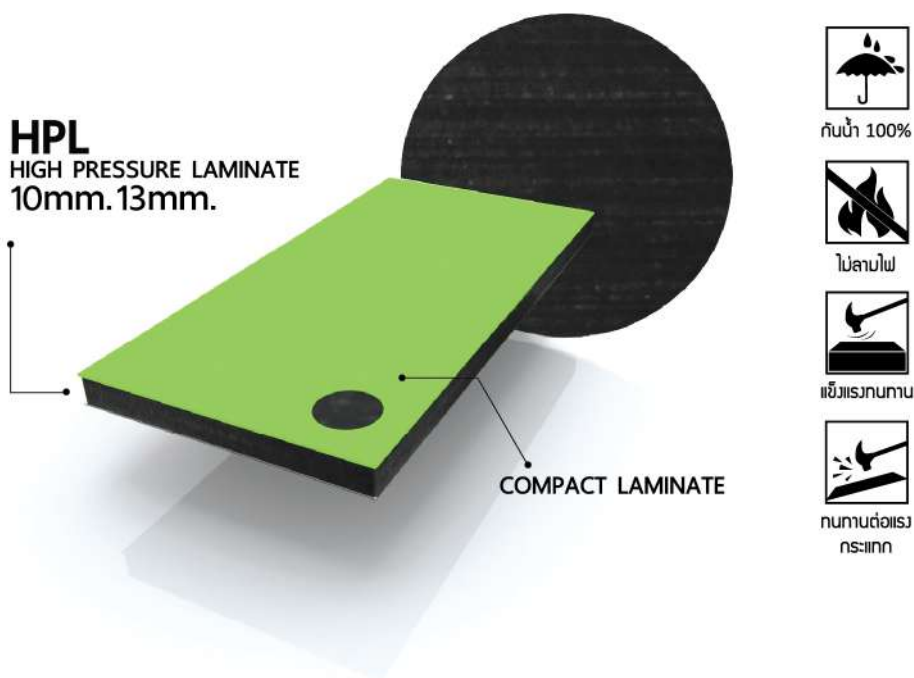

WELCRAFT PRODUCTS CO.,LTD.



www.welcraft.com



Rama III Branch
Tel. (+662) 295-2444
Fax. (+662) 295-2837-8



Rama III Branch
2534/233 Soi Rat U-thit 1
Rama III Road, Bangklo
Bangkorlaem, Bangkok 10120



Pracha-Uthit Branch
Tel. (+662) 463-8780-1
Fax. (+662) 463-8832



Pracha-Uthit Branch
599 Moo 10 Naiklongbangplakod
Prasamoot Jadee
Samutprakan 10290





THE LEADER OF TOILET PARTITION

STANDARD GRADE



Mocca Firwood
Willy-hw102

Sand Oak
Willy-hw103

Grey Elm
Willy-hw104

American Walnut
Willy-hw105



The toilet cubicle finish
shall be Sand Oak.



THE LEADER OF TOILET PARTITION

STANDARD GRADE

G-General

