


Please provide C11 ceiling specification for indicated rooms ceilings. We found until C10 in finishing schedule.

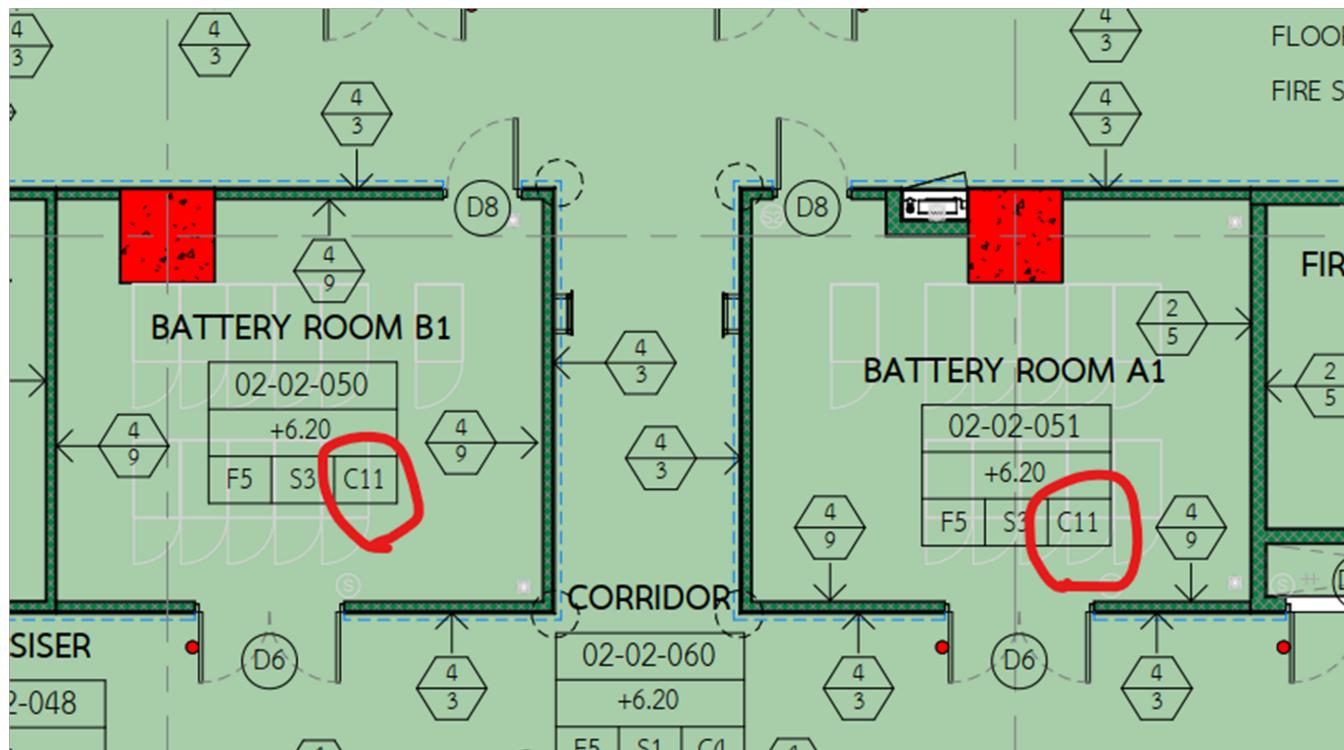

(C7)	TOILET	GYPSUM BOARD CEILING	9 MM. THK MOISTURE RESISTANT GYPSUM BOARD 4 TAPER EDGE, PLASTER WITH READY MADE ACCESS PANEL	SIAM GYPSUM SCG
(C8)	GENERATOR ROOM	EXPOSED CEILING	EXPOSED CEILING WITH EXTERNAL PAINT	ROCKWOOL
(C9)	DATA HALL	EXPOSED CEILING	600X1200 MM. STRUCTURE CEILING GIRD WITH CEILING TILE 580X1180 (THK) VINYLTOUCH DUST-FREE GYPSUM CEILING BOARD	TOA / TATE OR CRS
(C10)	CHILLER PLANT ROOM	ACOUSTIC CEILING	EXPOSED CEILING PLASTER 100 MM. THK ROCKWOOL 80KG/m ³ WRAP WITH BLACK GLASS CLOTH MECHANICAL FIXING	

รายการวัสดุ FINISHING SCHEDULE

FLOOR FINISH (รายการวัสดุพื้น)				WALL FINISH (รายการวัสดุผิวน้ำหนา)					
FLOOR NO.	LOCATION	DESCRIPTION	SPECIFICATION	SUPPLIER	WALL NO.	LOCATION	DESCRIPTION	SPECIFICATION	SUPPLIER
F1	HALL, LOBBY, MANTRAP	FLOOR TILE	600X1200 HOMOGENOUS FLOOR TILE NON SLIP R10 REFER TO ID DWGS. (TO PROVIDE 50 MM. SLAB SETDOWN)	COTTO OR VECERA	1	HALL, GF LIFT LOBBY	WALL PLASTER	WALL PLASTER WITH SKIM COATED AND EMULSION PAINT	LOCAL
F2	CORRIDOR	EPOXY FLOOR	CONCRETE STEEL TROWEL FINISH WITH 2 MM THK. SIKAFLOOR 81 EPOCEM AND EPOXY 2 MM. SIKAFLOOR 263SL HC SYSTEM OR WEBERFLOOR CEM BM 2 MM.+WEBERFLOOR 520 SL 2MM	SIKA / WEBER	2	OFFICE, M&E STORE, STAIR	WALL PLASTER	WALL PLASTER WITH INTERNAL EMULSION PAINT	TOA
F3	BATTERY RM	RAISED FLOOR	DURABLE ANTI-STATIC VINYL LAMINATE TO RAISED FLOOR TILE TATE IHCSF 2000 FLOOR TILE TYPE SEE DRAWING AR-	TATE SITEM	3	DATA HALL, CRAH, OFFICE, CORRIDOR	PAINT	INTERNAL EMULSION PAINT FINISH OVER GYPSUM BOARD PARTITION	TOA
F3A	DATA HALL, BATTERY RM	RAISED FLOOR	TATE DIRECTAIRE AL 60 CM. PANEL WITH SINGLE ZONE OPPOSED BLADE DAMPER — NOT USE	TATE SITEM	4	TOILET, JANITOR, CHARGING ROOM	WALL PLASTER	WALL PLASTER WITH WATERPROOF SYSTEM SIKA TOPSEAL 107 AND CERAMIC WALL TILE 400X800 MM. WALKS/1.0 WHITESOFT	SIKA
F3B	DATA HALL, BATTERY RM	RAISED FLOOR	TATE IHCSF 2000 HPL LAMINATED FINISH WITH KOLDLOK SURFACE MOUNT — NOT USE	TATE SITEM	5	MEP ROOM, AHU ROOM	WALL PLASTER	WALL PLASTER WITH INTERNAL EMULSION-SEMI-GLOSS PAINT	TOA
F3C	BATTERY RM	BELOW RAISED FLOOR	WATERPROOF SYSTEM WEBERDRY S3000S 1.5 MM. THK ON STRUCTURE SLAB/50 MM. SCREED AWEBERFLOOR CEM MB+WEBERFLOOR 520 SL	TATE SITEM	6	MEETING, PRESENTATION ROOM	ID WALL	DECORATIVE ACOUSTIC WALL REFER ID DRAWING	
F4	STAIR	EPOXY FLOOR	CONCRETE STEEL TROWEL FINISH WITH PAINT FINISH SIKAFLOOR -264HC SYSTEM	SIKA	7	WATER TANK	RC WALL	WATER PROOF SYSTEM SIKA TOPSEAL 109 OVER RC WALL	
F5	MEP ROOM	EPOXY FLOOR	CONCRETE STEEL TROWEL FINISH WITH 2 MM. THK SIKAFLOOR 81 EPOCEM AND EPOXY FINISH 2 MM. THK SIKAFLOOR -263SL HC SYSTEM OR WEBERFLOOR CEM BM 2 MM.+WEBERFLOOR 520 SL 2MM	SIKA / WEBER	8	CORRIDOR	PAINT	PRECAST CONCRETE WALL WITH INTERNAL EMULSION SEMI-GLOSS PAINT	TOA
F6	DATA HALL 2FL - 5FL	EPOXY FLOOR	WATERPROOF SYSTEM SIKABITUSEAL 1500 SA ON STRUCTURE SLAB/50 MM. SCREED STEEL TROWEL FINISH FLATNESS FM2 / EPOXY PRIMER/ SIKAFLOOR 161SL HC 2MM. THK + COPPER STRIP 3X3 M SPACING/ SIKAFLOOR-220W CONDUCTIVE + SIKAFLOOR 2350 ESD SELF SMOOTHING ELECTROSTATIC DISSIPATIVE EPOXY RASIN GLOSS FINISH 2 MM. THK	SIKA	9	MEP ROOM	PAINT	INTERNAL EMULSION-SEMI-GLOSS PAINT OVER GYPSUM BOARD PARTITION	TOA
F7	TOILET, PANTRY, JANITOR, CHANGING ROOM	CERAMIC TILE	400X800 HOMOGENOUS TILE WALK/1.0 BLACKSOFT WITH WATERPROOF SYSTEM SIKA TOPSEAL 107 SYSTEM	SIKA / COTTO	21	EXTERNAL BUILDING	WALL PLASTER	WALL PLASTER WITH EXTERNAL PAINT FINISH	TOA
F8	TECHNICAL ASSISTANT RM.	CARPET TILE	500X500 CARPET TILE REFER TO ID DWGS. (TO PROVIDE 50 MM. SLAB SETDOWN)	INTERFACE	22	EXTERNAL BUILDING	PRECAST CONCRETE WALL	PRECAST CONCRETE WALL COAT WITH EXTERNAL PAINT FINISH	TOA
F9	LOADING AREA, RAMP	CONCRETE SLAB	CONCRETE STEEL TROWEL FINISH WITH FLOOR HARDENER (NON METALLIC) SIKAFLOOR -3QUARTZTOP GREY COLOUR	SIKA	23	DROP-OFF	WALL PLASTER	WALL PLASTER WITH COLOUR CEMENT FINISH	CERAC CURE
F10	CAR PARK	CONCRETE SLAB	CONCRETE FLOOR WITH TRAFFIC / CAR PARK PAINT TOA ROADLINE PAINT WHITE REFLECTIVE	TOA	WALL STRUCTURE (รายการวัสดุโครงสร้างผิวน้ำหนา)				
F11	WATER STORAGE TANK	CONCRETE SLAB	CONCRETE FINISH WITH WATERPROOF SYSTEM, SIKA 1.5 MM. SIKASHIELD W159 ED AT BOTTOM SLAB OR BTTUTHANE 3000 HC AND WALL BELOW GROUND, SIKA TOPSEAL 107 INSIDE TANK ALL 6 SIDE	SIKA / GCP	SKIRT NO.	LOCATION	DESCRIPTION	SPECIFICATION	SUPPLIER
F12	GREEN AREA	GRASS	GRASS ON 300 MM. SOIL DEPTH, GLASS SHALL BE TROPICAL CARPET GLASS (MALAYSIA GLASS)	LOCAL	1	AS INDICATED		CONCRETE COLUMN OR WALL STRUCTURE	LOCAL
F13	CDU PLATFORM, GENSET	PU FLOOR	CONCRETE FLOOR WITH SIKAFLOOR 359N	LOCAL	2	AS INDICATED		140 MM. THK CONCRETE BLOCK 2HR. FIRE RATE	
F14	SPARE SPACE	CONCRETE SLAB	CONCRETE STEEL TROWEL FINISH TO RECEIVE 6 MM. THK(MAX) CARPET FLOOR TILE	LOCAL	3	AS INDICATED		90 MM. THK CONCRETE BLOCK 2HR. FIRE RATE	
F15	STEEL GRATING FLOOR (FIBER,CHILLER PIPE RISER)		SEE STRUCTURAL ENGINEER DRAWING	LOCAL	4	AS INDICATED		15 MM. FIRERATED x 2 LAYERS (FIRE BLOC) GYPSUM BOARD 2 HR. FIRE RATED + METAL STUD PROWALL ELEPHANT NO.24 C74U76 + 50 MM. NOIZEBLOC	SIAM GYPSUM SCG
F16	STAGING ROOM	CONCRETE SLAB	CONCRETE STEEL TROWEL FINISH WITH 2 MM. VINYL SHEET ARMSTRONG PASTELL CONDUCTIVE	SIKA	5	AS INDICATED		120 MM. PRECAST CONCRETE PANEL REFER TO STRUCTURAL ENG. DWGS	
R1	ROOF DECK	CONCRETE SLAB	CONCRETE WITH INSULATION, SARNAFIL MEMBRANE 50 MM. XPS/SARNAFIL G410L SYSTEM (STANDARD BUILDUP XPS) AND 75 MM. THK CONCRETE COVER SLOPE TO ROOF DRAIN	SIKA	6	AS INDICATED		CONCRETE WALL WATER TIGHTNESS (PVC WATER STOP SIKA WATER BARS)	SIKA
R2	ROOF SLAB	CONCRETE SLAB	CONCRETE WITH 50 MM. XPS/SARNAFIL G410-15L	SIKA	7	AS INDICATED	GYPSUM BOARD	15 MM. GYPSUM BOARD x 2 + METAL STUD PROWALL ELEPHANT NO.24 C74U76 + 50 MM. THK NOIZEBLOC	SIAM GYPSUM SCG
SKIRTING FINISH (รายการวัสดุบัวเชิงผนัง)					8	AS INDICATED		200 MM. THK RC WALL CLASS 3 BULLET PROOF	
SKIRT NO.	LOCATION	DESCRIPTION	SPECIFICATION	SUPPLIER	9	AS INDICATED		12.7 MM. GLASS BLOC + METAL STUD PROWALL ELEPHANT NO.24 C74U76 + 50 MM. THK NOIZEBLOC	
S1	CORRIDOR	SKIRTING	400 MM. HIGH 1.5 MM. THK ALUMINIUM CHEQUER PLATE	LOCAL	10	CHILLER PLANT	SANDWICH WALL PANEL		KINGSPAN
S2	OFFICE	SKIRTING	100 MM. ALUMINIUM	ALLOY BUILD SMART	11	TR ROOM	SANDWICH WALL PANEL	100 MM. THK KINGSPAN ROCK WOOL 125 Kg/CUM 1150 MM. WIDTH RAL PER ELEVATION	KINGSPAN
S3	STAIR, PUMP ROOM , MEP ROOM	SKIRTING	100 MM. HIGH WALL PAINT	TOA				100 MM. THK KINGSPAN -PIR 2500 MM. x 4500 MM. AND 3000 MM. x 4500 MM. PER ELEVATION	
S4	GOODS LIFT LOBBY	SKIRTING	973 MM. HIGH 1.5 MM. THK ALUMINIUM CHEQUER PLATE	LOCAL	NOTE	1. ALL RC. STRUCTURE SLAB AND WALL SHALL BE USE PVC. WATER STOP SIKA WATER BARS.			
S5	DATA HALL	SKIRTING	100 MM. HIGH PVC SKIRTING	LOCAL		2. ALL EQUIVALENT MATERIAL TO BE APPROVED BY DESIGN CONSULTANT			
S6	LOBBY	SKIRTING	100 MM. HIGH STAINLESS STEEL	LOCAL		3. ALL EQUIVALENT RAISED FLOOR MATERIALS TO BE APPROVED BY DESIGN CONSULTANT AND CLIENT			
S7	MDF	SKIRTING	100 MM. HIGH ANTI-STATIC VINYL SKIRTING	LOCAL		4. ALL GF. BOTTOM SLAB AND RC WALL SHALL BE WITH WATERPROOF SYSTEM 1.5 MM. SIKA SHIELD W159 ED OR BTTUTHANE 3000 HC BY GCP			
S8	AS INDICATED	SKIRTING	REFER TO INTERIOR DESIGN DRAWINGS			5. ALL ALUMINIUM COMPOSITE PANEL SHALL BE NON-COMBUSTIBLE MATERIALS CORE A2 OR SOLID ALUMINIUM			
CEILING FINISH (รายการวัสดุฝ้าเพดาน)							6. ALL WATERPROOF IS A SYSTEM AND SHALL BE INCLUDE WITH ACCESSORIES FROM MANUFACTURE. INSTALLATION SHALL BE BY MANUFACTURE CERTIFY APPLICATOR		
CEILING NO.	LOCATION	DESCRIPTION	SPECIFICATION	SUPPLIER			7. ALL EXTERNAL PAINT SHALL BE TOA SUPERSHIELD OR NIPPON PAINT WHEATHER AND INTERNAL PAINT SHALL BE TOA SUPERSHIELD DURACLEAN OR NIPPON PAINT HEALTH CARE		
C1	LIFT LOBBY, CHECKED HALL	GYPSUM BOARD CEILING	9 MM. THK GYPSUM BOARD, 4 TAPERED EDGE , PLASTER AT JOINT AND EMULSION PAINT WITH 600X600 MM. READY MADE ACCESS PANEL	SIAM GYPSUM SCG			8. PREFERRED STRUCTURAL CEILING GRID MANUFACTURER ARE CRS,TATE.		
C2	LIFT LOBBY, CHECKED HALL	GYPSUM BOARD CEILING	CEILING REFER TO ID. DWGS.	SIAM GYPSUM SCG			9. METAL SANDWICH PANEL SHALL BE KINGSPAN FM APPROVED 4881		
C3	SECURITY 2	ACOUSTIC CEILING	ACOUSTIC CEILING ON 600X1200 MM. T-BAR RH99 CORTEGA ARMSTRONG	SIAM GYPSUM SCG					
C4	CRAH, MEP ROOM, TRUCK, LOADING AREA	EXPOSED CEILING	EXPOSED CEILING SKIM COATED AND EMULSION PAINT	TOA					
C5	DROP-OFF	ALUMINIUM CEILING	2 MM. THK ALUCOLUX ALUMINIUM PANEL	BFM					
C6	WATER STORAGE TANK	EXPOSED CEILING	EXPOSED CEILING AND WATERPROOF SIKA TOPSEAL 107	SIKA					
C7	TOILET	GYPSUM BOARD CEILING	9 MM. THK MOISTURE RESISTANT GYPSUM BOARD 4 TAPER EDGE, PLASTER WITH READY MADE ACCESS PANEL	SIAM GYPSUM SCG					
C8	GENERATOR ROOM	EXPOSED CEILING	EXPOSED CEILING WITH EXTERNAL PAINT	ROCKWOOL					
C9	DATA HALL	EXPOSED CEILING	600X1200 MM.STRUCTURE CEILING GIRD WITH CEILING TILE 580X1180 (THK) VINYLTOUCH DUST-FREE GYPSUM CEILING BOARD	TOA / TATE OR CRS					
C10	CHILLER PLANT ROOM	ACOUSTIC CEILING	EXPOSED CEILING PLASTER 100 MM. THK ROCKWOOL 80KG/m³ WRAP WITH BLACK GLASS CLOTH MECHANICAL FIXING						
C11	BATTERY ROOM	PAINT	UNDER SIDE OF METAL SLAB TO BE CLEANED , APPLY PRIMER RUSTTECH 100 MICRON THICKNESS 1 LAYER , AND APPLY INTERNEL PAINT TOA DURACLEAN MATT FINISH 3 LAYERS						

CLIENT
ST Telemedia Global Data Centres
 ST GDC (THAILAND) CO., LTD.
 944 Mitr Office Tower, 22nd-23rd Floor
 Rama 4 Road, Wangmai, Pathumwan, Bangkok 10330

ENGINEER
aurecon
 www.aurecongroup.com
 AURECON CONSULTING (THAILAND) CO., LTD.
 89 AIR Capital Center Building, 21st Floor, Unit 2104-2107
 Ratchadapisek Road, Dindang, Dindang, Bangkok 10400

STRUCTURAL REVIEWER
 สยาม เอเชียทิคส์ กส. 1754
STRUCTURAL
 วิจิต ชัยกานต์ กส. 1488
 ศิริรุจ ใจรัก กส. 9229
 นิตยา มีนาภิรักษ์ กส. 64414
ANTI-FIRE AND PROTECTION
 พันธ์ พันธ์สินธ์ กส. 209
 ศิริรุจ ใจรัก กส. 438
 กานต์ บีบี กส. 3502
 ปัชิป บีบี กส. 3907
 ธนา ภูมิรุจ กส. 4891
 พงษ์ พันธ์สินธ์ กส. 6968
ELECTRICAL AND COMMUNICATIONS
 มนต์ พันธ์สินธ์ กส. 1297
 ชาญ มนต์สินธ์ กส. 6721
 ปริญต์ พันธ์สินธ์ กส. 6647
 ราชนร มนต์สินธ์ กส. 53962
 บุณย์ พันธ์สินธ์ กส. 59400

MECHANICAL ENGINEER
 ถุงดี ศรีธรรมรงค์ กส. 848
 หาด สงขลา กส. 4976
 ชุดดี พีระพงษ์ กส. 5005

ARCHITECTS
StevenLeach
 Partners in creative solutions
 บริษัท ลีช จำกัด (มหาชน) จำกัด
 62 ถนนสุขุมวิท แขวงคลองเตย เขตคลองเตย กรุงเทพมหานคร 10130

ARCHITECT
 ฐิติ ฐิติวนารถ กส. 603
 แอนดี้ บาร์บูรี่ กส. 3222

REV DATE 01/10/25 **FOR CONSTRUCTION** TS
SCALE 1 : 50 **SIZE** A0 **APP**
DRAWN CC **APPROVED DATE** 17.10.25
DESIGNED SLA **DATE**
CHECKED TS **DATE**
PROJECT

รายการเมมเบอร์กลุ่มอิทธิพล
 8 ท่าน จำนวน 1 หนึ่ง
 ยอดรวม 28 ยอดรวมเมมเบอร์กลุ่ม
 บานาบี กรุงเทพฯ 10240

TITLE
 FINISHING SCHEDULE

DRAWING NUMBER 523213 - 02 - DRG - AR-0001
REV 0