

REQUEST FOR INFORMATION (RFI)

PROJECT :	BKK2	R.F.I. NO. :	523213-01-RFI-ME-0006
TO :	CTA	ATTENTION :	CTA
SUBMITTED DATE	12-Jan-26	NEED REPLY BY DATE :	19-Jan-26

SUBMISSION OF : ☒ Q&A ☒ Drawing ☐ Document ☐ Others (as specified below)

SUBJECT : Request for Confirmation - Cooling Coil amount and type for PAHU 1st & Roof FL

Total Page (s) : 3 (Including this page)

FUNCTION : ☐ Structural (ST) ☐ Electrical & Communication (EL) ☒ Mechanical (ME) ☐ Vertical Transport (VT)

☐ Architectural (AR) ☐ Fire Protection (FI) ☐ Hydraulic & Sanitary (HY) ☐ Other (O)


(1) CONTRACTOR REQUEST FOR INFORMATION :


With reference to DWG No. 523213-02-DRG-ME-0114, the detailed drawing indicates 2 cooling coils, whereas DWG No. 523213-02-DRG-ME-0204 shows 3 cooling coils.

1) Kindly confirm the correct quantity of cooling coils to be considered.

2) Kindly confirm whether DX-Coil 2 and 3 are DX coils (refrigerant type) or cooling coils (chilled water type).

*NOTE : It would be an additional cost some for items.

Requested by : 
Engineering Manager


Reviewed by : 
Project Manager

(2) ATTN : Commtech Asia (Thailand)


☐ For Approval ☐ See Note ☒ Please Clarify

Note : Aurecon : Please Confirm Cooling Coil amount and type for PAHU 1st & Roof FL

From : GAA Group

By : 
Name / Position : Mr. Itsarate Trachuengtong/
Project Manager

Date : 12-Jan-26

Reviewed By : 
Commtech Asia (Thailand)

Name / Position : Bundit, S /
Mechanical Project Manager


Date : 09 Feb 2026

(3) ATTN : AURECON

☐ For Approval ☒ See Note ☐ Please Clarify

Note : Please see equipment schedule.

From : Commtech Asia (Thailand)

By : 
Name / Position : ()

Date : 09/02/2026

Reviewed By : AURECON

Name / Position : (Kritchawat Onratn)

Date : 09/02/2026

(4) ATTN : STT GDC

☐ Clarification only ☐ Not Approved


☐ Approved for proceeding work

☐ Approved with comments, proceeding work in compliance with comments

☐ Approved with comments, not for proceeding work and need to re-submit

Note :

From : AURECON

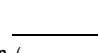By : 
Name / Position : ()

Date : 09/02/2026

Reviewed By : STT GDC

Name / Position : ()

Date : 09/02/2026

CONTRACTOR DOCUMENT REVIEW

☒ ACCEPTED

☐ REJECTED

☐ MAKE CORRECTIONS NOTED & PROCEED

☐ REVISE AND RESUBMIT

Aurecon Consulting (Thailand) Co., Ltd.

By : Kritchawat Onratn

Date issued : 09/02/2026

Project No : 523213

Date received : 09/02/2026




This review is only for general confirmation with the design concept of the project and general compliance with the information given in the contract documents. Any action shown is subject to the requirements of the contract document.

This review does not relieve the Contractor of his contractual obligations nor of his responsibilities of ensuring the work is complete accurate & correct.

Any amendment does not constitute an order or authority for a price variation to the contract.

CC : ☒ STT GDC ☒ AURECON ☒ Commtech Asia (Thailand) ☒ GAA ☐ OTHERS.....

LEGEND	
	WATER LEVEL SWITCH
	MOTOR
	VARIABLE SPEED DRIVE - FOR ACMV SYSTEM
	TEMPERATURE SENSOR WITH TRANSMITTER
	MAGNETIC FLOW METER
	ULTRASONIC FLOW METER
	FLOW SENSOR WITH TRANSMITTER
	FLOW SWITCH
	PRESSURE TRANSMITTER
	DIFFERENTIAL PRESSURE TRANSMITTER
	DIFFERENTIAL PRESSURE SWITCH
	FLOW ELEMENT
	THERMOSTAT
	COMBINED TEMPERATURE / HUMIDITY TRANSMITTER (SPACE SENSOR)
	VIBRATION SWITCH
	DUCT TYPE SMOKE DETECTOR
	AIR PRESSURE SENSOR
	AIR DIFF. PRESSURE SWITCH
	AIR PRESSURE TRANSMITTER
	REFRIGERANT SENSOR
	GAS LEAK DETECTOR
	HI-ACCURACY TEMPERATURE SENSOR

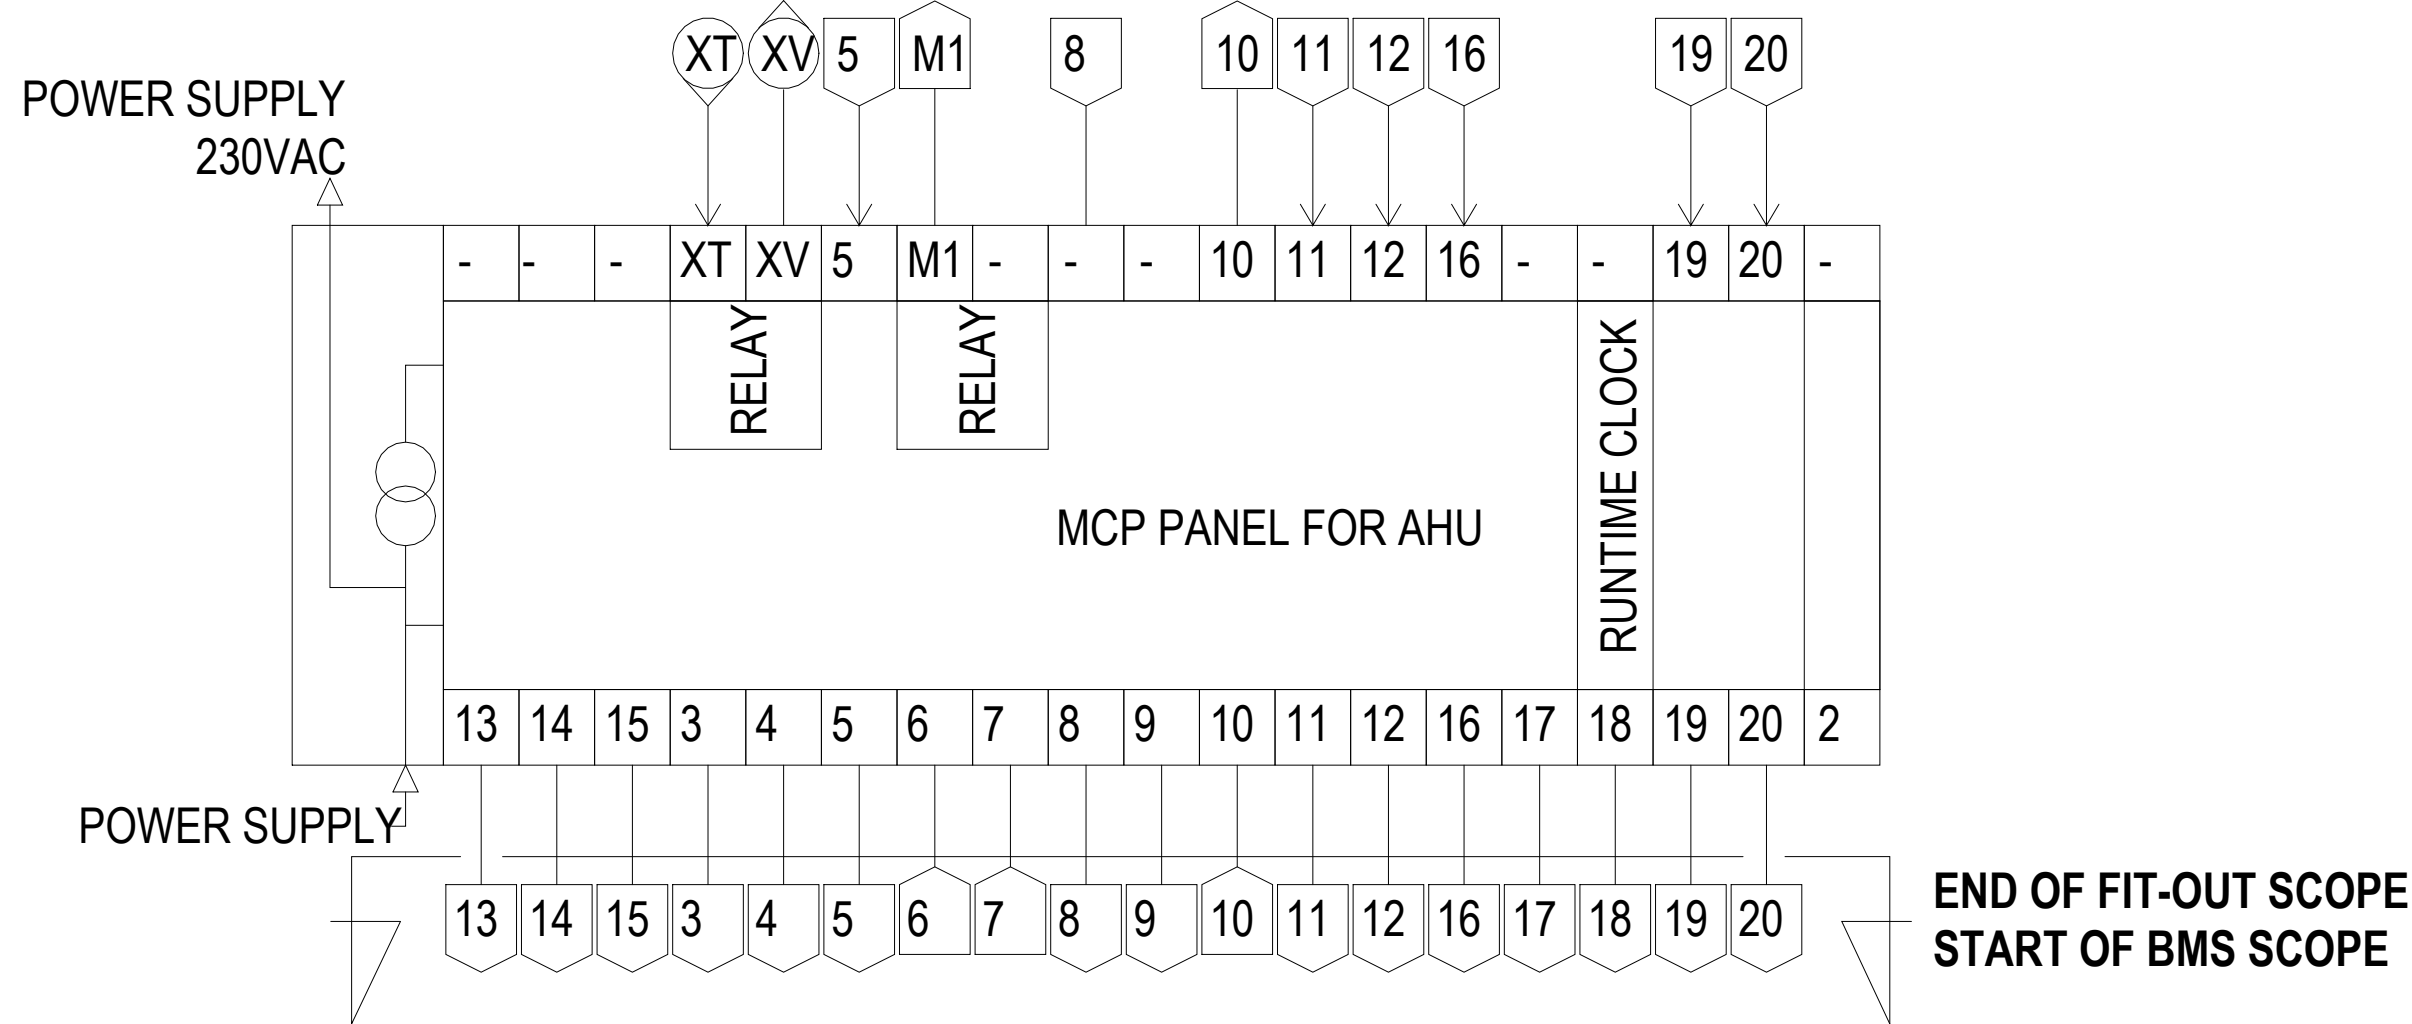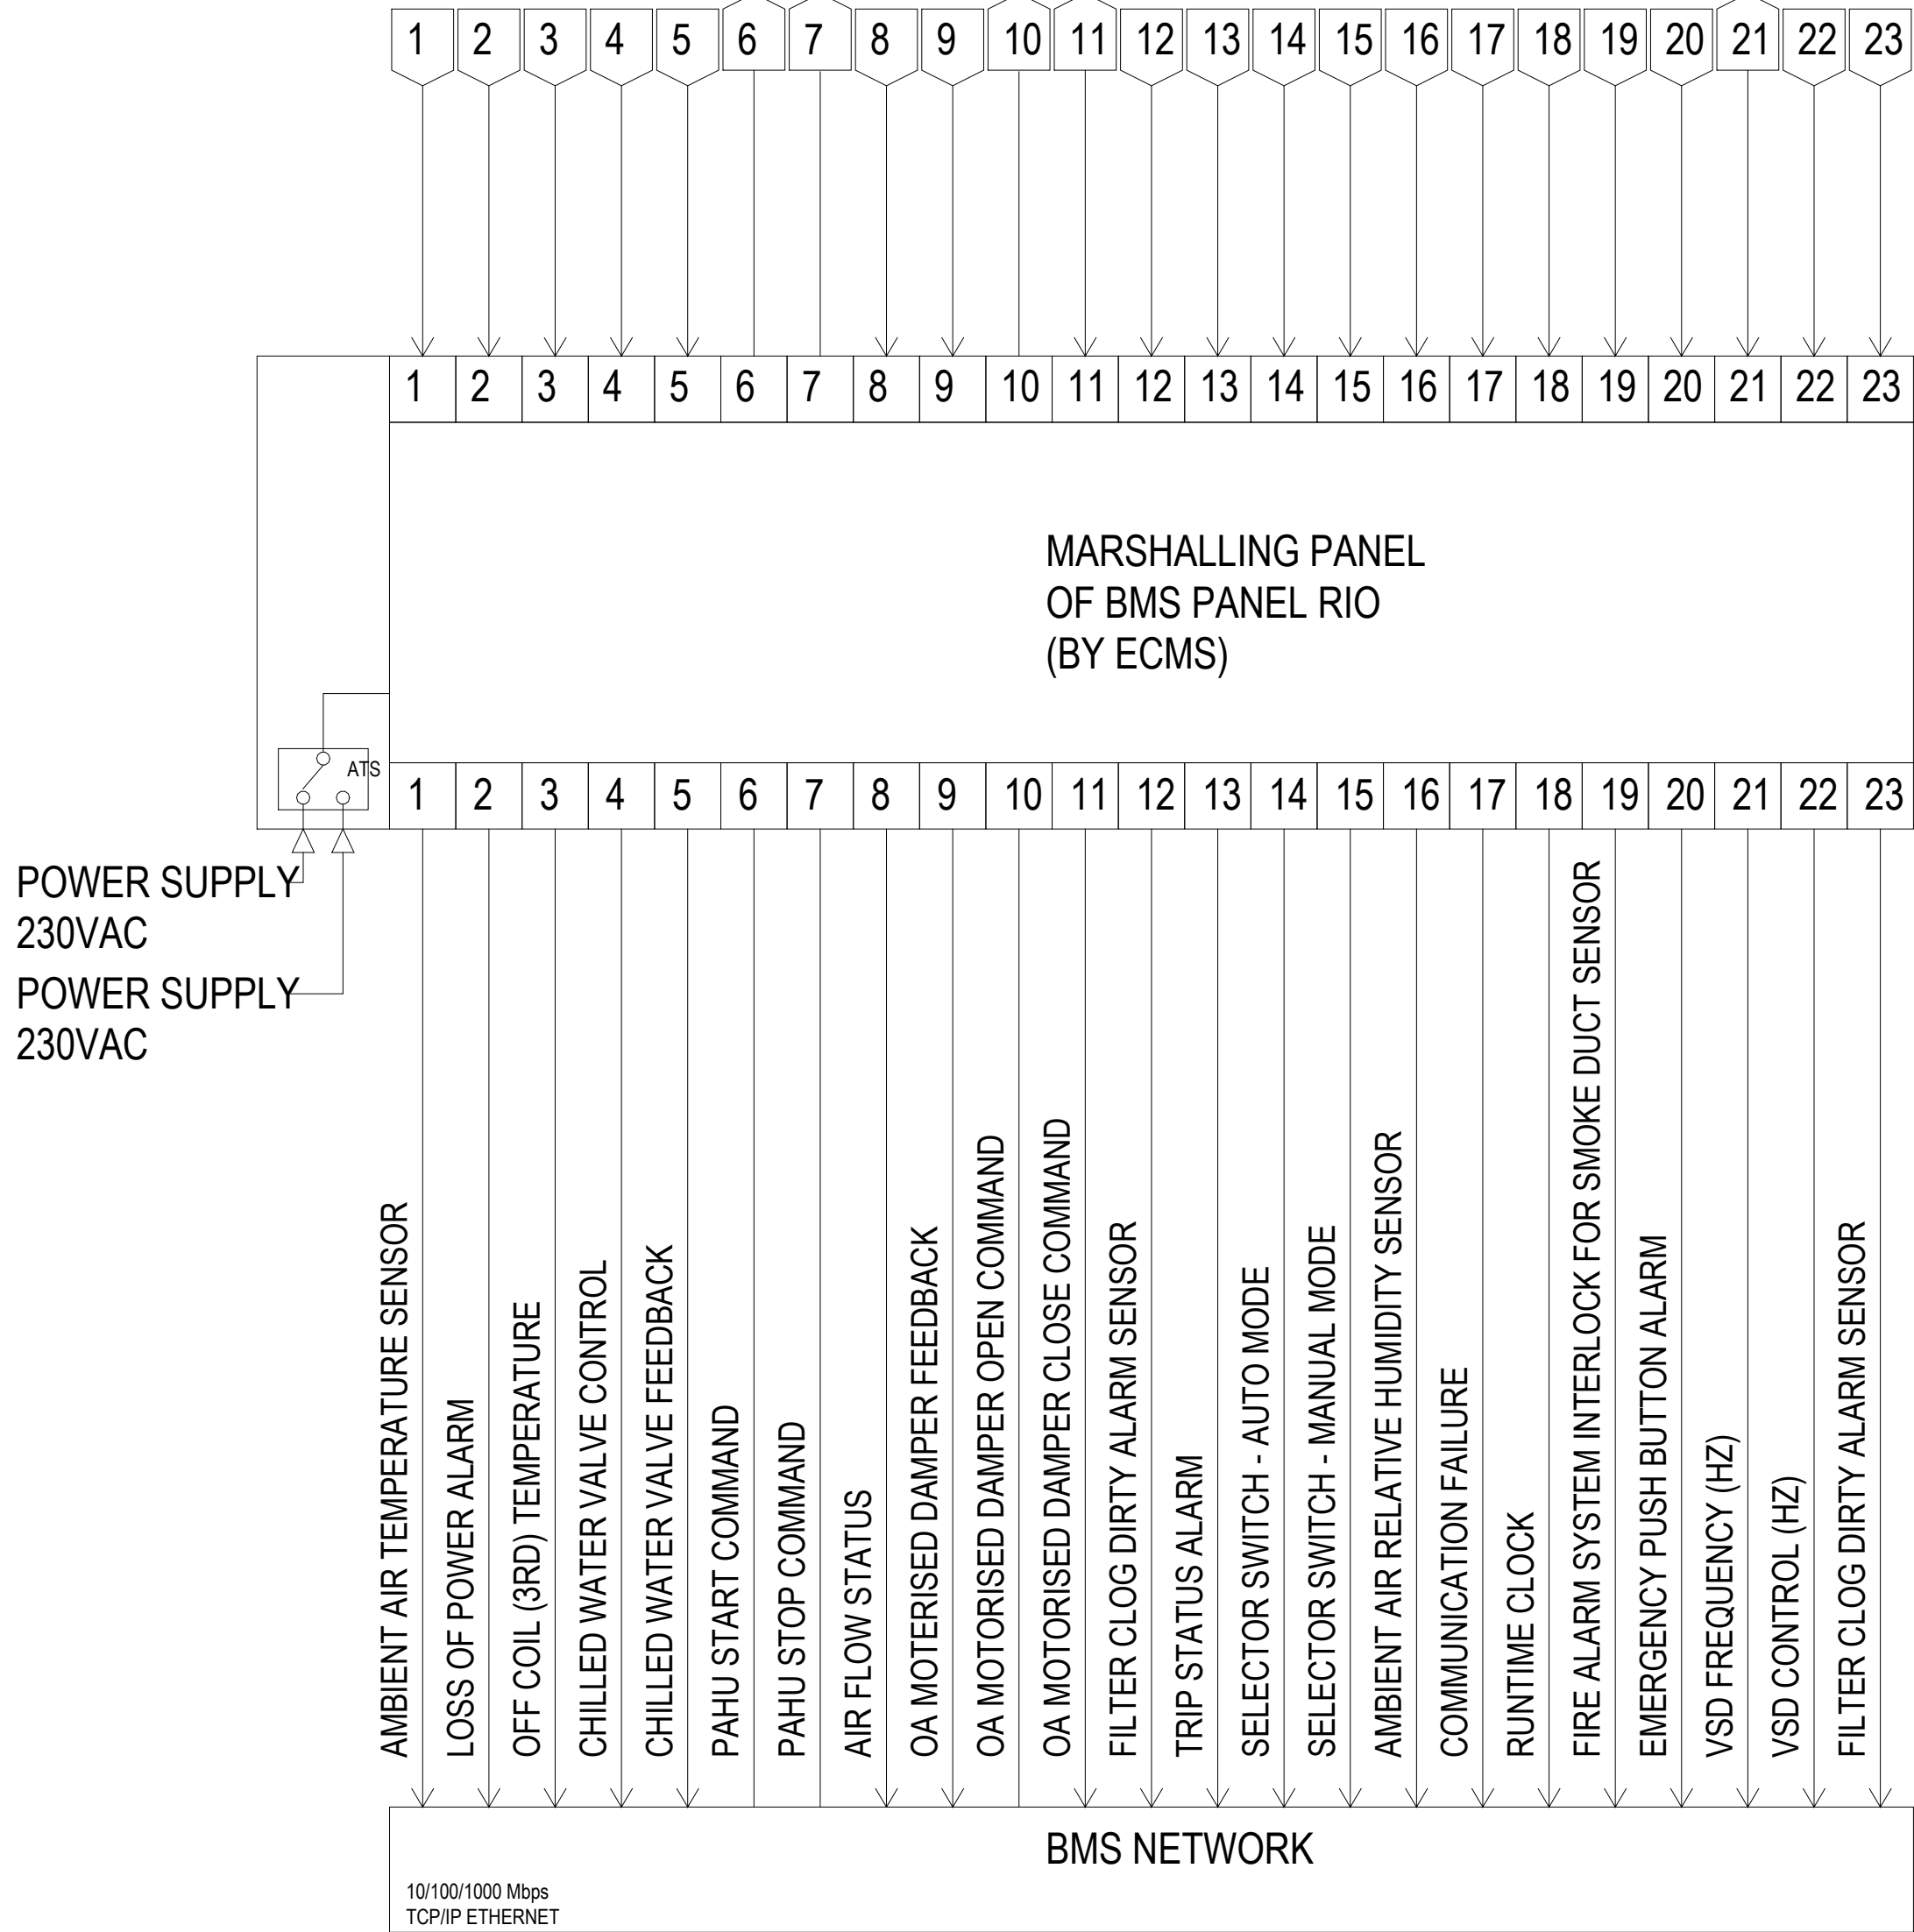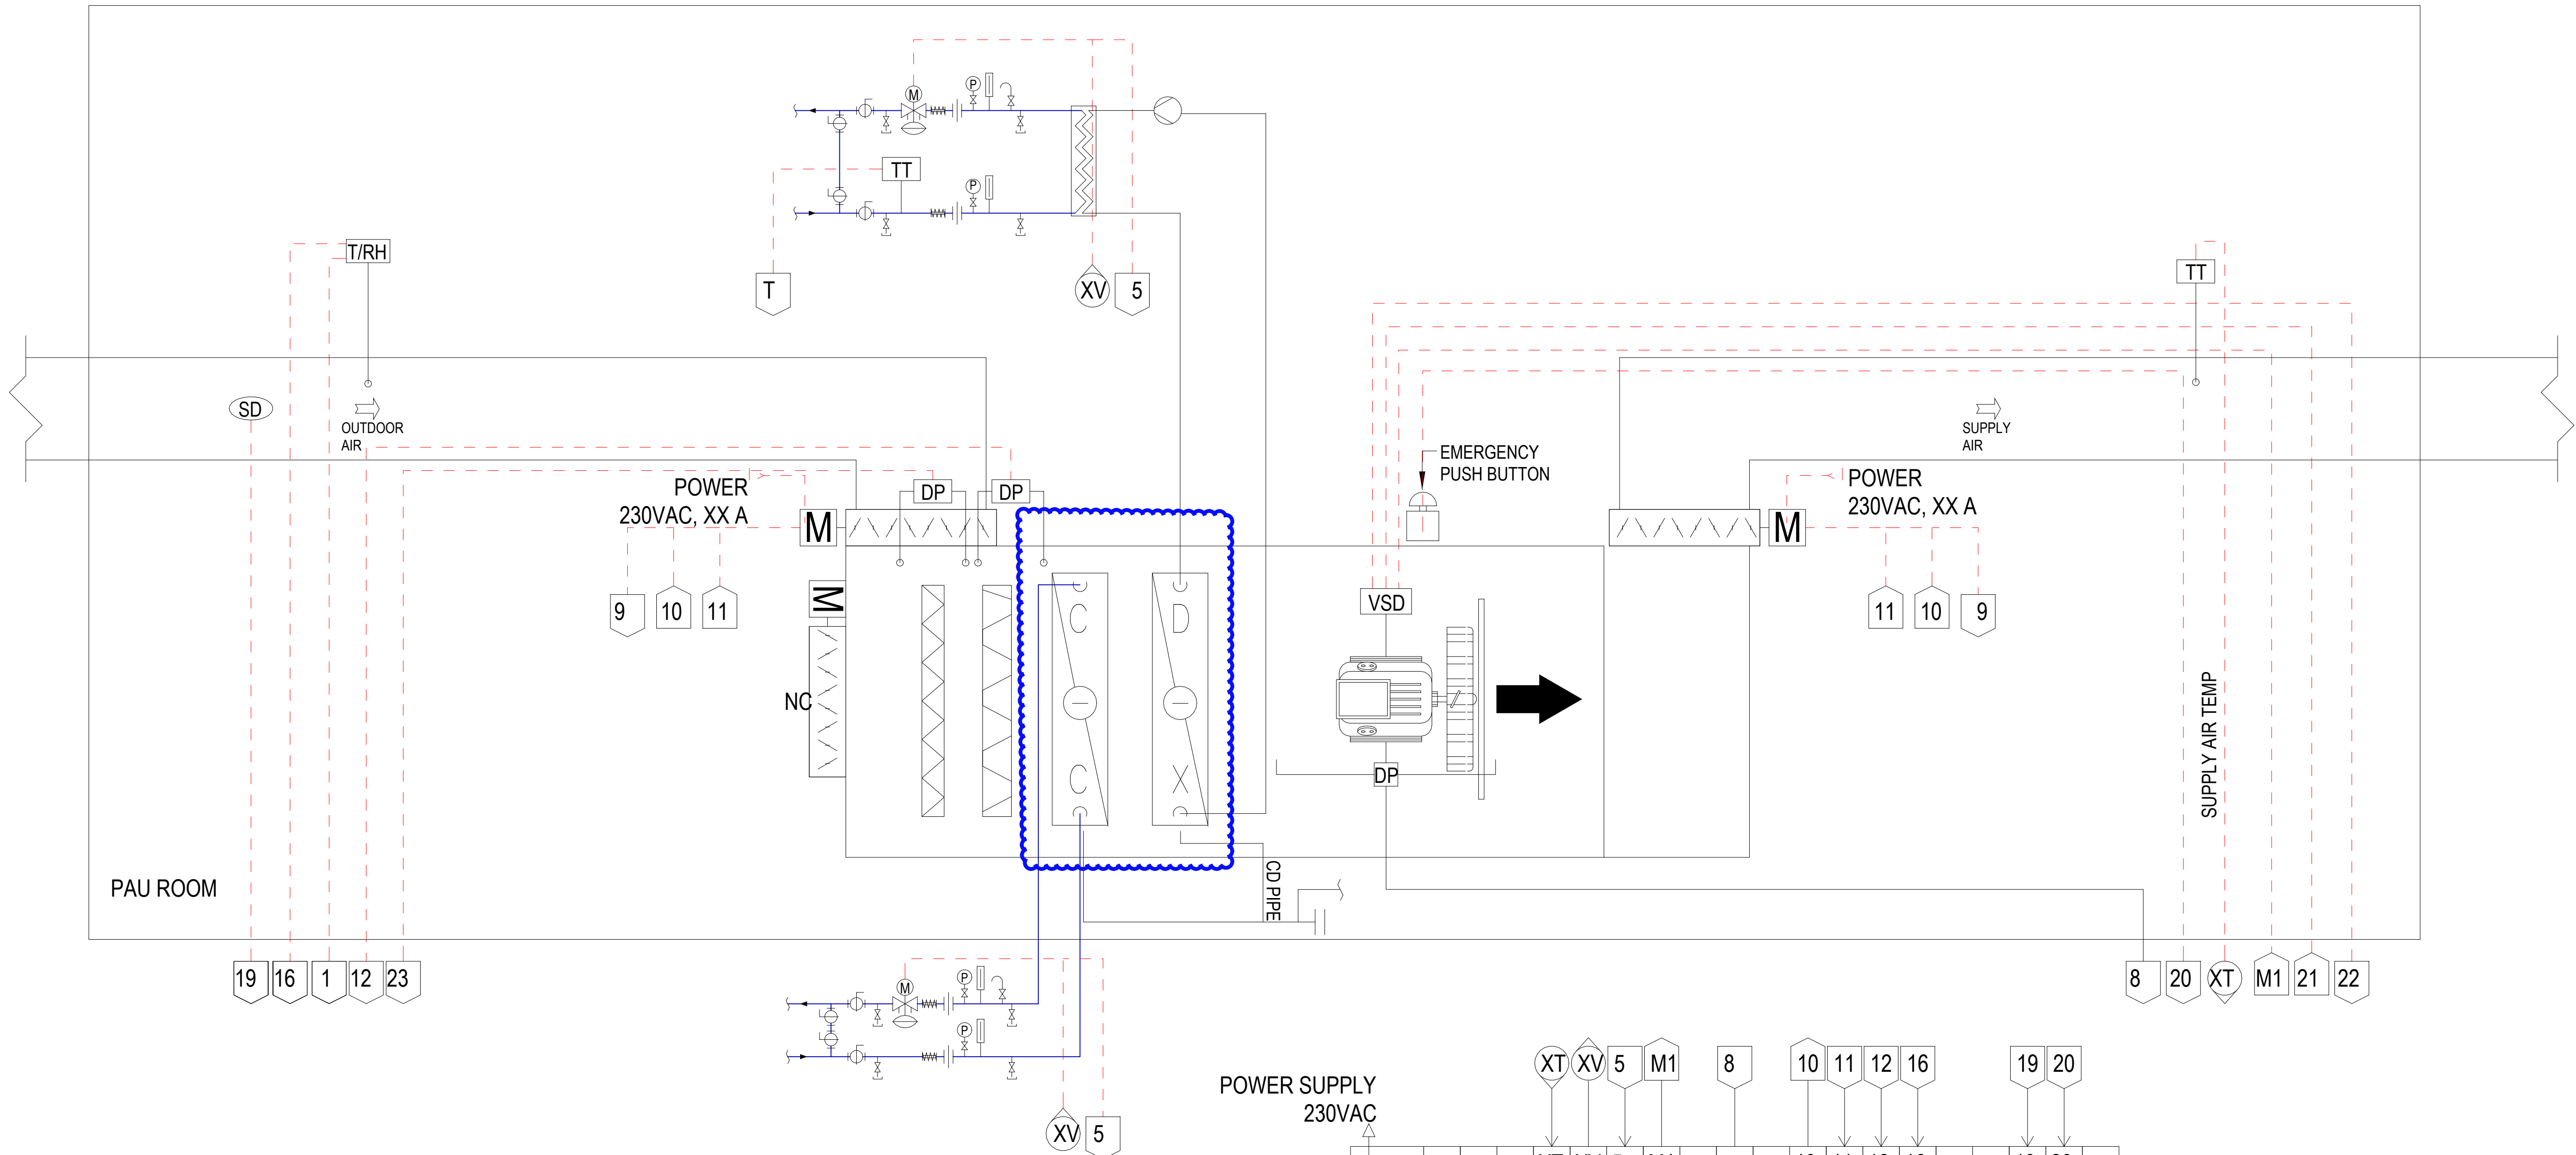

NOTE: MINIMUM OF 25% SPARE POINTS ARE TO BE PROVIDED BY ECMS

DEDICATED PRE-COOL OUTDOOR AIR HANDLING UNIT NTS

OWNER
STTelemedia
Global Data Centres
STT GDC (THAILAND) CO., LTD.
601 Wireless Office Tower, 21st-23rd Floor
Rama 4 Road, Wangmai, Pathumwan, Bangkok 10330

ENGINEERING
aurecon
www.aurecongroup.com
AURECON CONSULTING (THAILAND) CO., LTD.
88 AIA Capital Center Building, 21st Floor, Unit 2104-2107
Ratchaprasong Road, Chongkeng, Bangkok 10330

STRUCTURAL REVIEWER	
สมชาย งามจิตรพันธ์	ร.บ. 1754
STRUCTURAL	
วิวัฒน์ งามจิตรพันธ์	ร.บ. 1488
วิวัฒน์ งามจิตรพันธ์	ร.บ. 9229
วิวัฒน์ งามจิตรพันธ์	ร.บ. 64414

SANITARY AND FIRE PROTECTION	
วิวัฒน์ งามจิตรพันธ์	ร.บ. 209
วิวัฒน์ งามจิตรพันธ์	ร.บ. 438
วิวัฒน์ งามจิตรพันธ์	ร.บ. 3502
วิวัฒน์ งามจิตรพันธ์	ร.บ. 3907
วิวัฒน์ งามจิตรพันธ์	ร.บ. 4891
วิวัฒน์ งามจิตรพันธ์	ร.บ. 6968
ELECTRICAL AND COMMUNICATIONS	
วิวัฒน์ งามจิตรพันธ์	ร.บ. 1287
วิวัฒน์ งามจิตรพันธ์	ร.บ. 6447
วิวัฒน์ งามจิตรพันธ์	ร.บ. 6875
วิวัฒน์ งามจิตรพันธ์	ร.บ. 52996

AIR CONDITIONING AND VENTILATION	
วิวัฒน์ งามจิตรพันธ์	ร.บ. 848
วิวัฒน์ งามจิตรพันธ์	ร.บ. 4976
วิวัฒน์ งามจิตรพันธ์	ร.บ. 5005

ARCHITECTURAL
Steve Leach
Partners in creative solutions
STEVEN J. LEACH ARCHITECTS LIMITED
The Wireless Building, 19th Floor, Unit 1902-1903
62 St James Place, London, W1P 0LP, England

ARCHITECT	
วิวัฒน์ งามจิตรพันธ์	ร.บ. 603
วิวัฒน์ งามจิตรพันธ์	ร.บ. 3222

REV	DATE	DESCRIPTION	APP
1	17/10/25	ISSUED FOR CONSTRUCTION	CH

SCALE	SIZE	CONSTRUCTION ISSUE
NTS	A0	NOT FOR BMS SUBMISSION
DRAWN	APPROVAL	DATE
SP		17/10/25
DESIGNED		
KC		
CHECKED		
SS		

PROJECT	
TERESA NORTH	
6 STOREY BUILDING	
โครงการอาคาร 6 ชั้น เทresa North	
พื้นที่อาคาร 6 ชั้น เทresa North 10240	
DRAWING TITLE	
MECHANICAL SERVICES P&ID DIAGRAM SCHEMATIC DEDICATED PRE-COOL OUTDOOR AIR HANDLING UNIT	
DRAWING NUMBER	
523213-02-DRG-ME-0114	

PRE-COOLED AIR HANDLING UNITS SCHEDULE

UNIT NO.		TH-BKK2-02-01-PAHU-001				TH-BKK2-02-07-PAHU-(001-003)			TH-BKK2-02-07-PAHU-004			TH-BKK2-02-07-PAHU-005			
AREA SERVED		LEVEL 1				ROOF			ROOF			ROOF			
QUANTITY		SET (S)				3			1			1			
PAU. TYPE		WU DOUBLE SKIN				WU DOUBLE SKIN			WU DOUBLE SKIN			WU DOUBLE SKIN			
		COOLING COIL	DX COIL 1	DX COIL 2	COOLING COIL	DX COIL 1	DX COIL 2	COOLING COIL	DX COIL 1	DX COIL 2	COOLING COIL	DX COIL 1	DX COIL 2		
UNIT POWER CONSUMPTION		KW				15.3			15.3			15.3			
COIL COND		DX COMPRESSOR TYPE	-	FIXED	INVERTER	-	FIXED	INVERTER	-	FIXED	INVERTER	-	FIXED	INVERTER	
		COMPRESSOR MIN.C.O.P	-	6.7	5.6	-	6.7	5.6	-	6.7	5.6	-	6.7	5.6	
		COMPRESSOR POWER	-	2.9	3.3	-	2.9	3.3	-	2.9	3.3	-	2.9	3.3	
		NO OF ROWS	9	4	5	9	4	5	9	4	5	9	4	5	
		TOTAL CAPACITY	51.2	19.5	18.3	126.7	48.3	45.2	126.7	48.3	45.2	126.7	48.3	45.2	
		SENSIBLE CAPACITY	19.1	5.8	6.5	47.2	14.4	16.0	47.2	14.4	16.0	47.2	14.4	16.0	
		CHW FLOW RATE	1.53	0.78	0.73	3.79	1.92	1.80	3.79	1.92	1.80	3.79	1.92	1.80	
		ENT. AIR TEMP	"CDB"/CWB	40.5/32.7	23.4/23.1	18.2/18.1	40.5/32.7	23.4/23.1	18.2/18.1	40.5/32.7	23.4/23.1	18.2/18.1	40.5/32.7	23.4/23.1	18.2/18.1
		LEAVING AIR TEMP.	"CDB"/CWB	23.4/23.1	18.2/18.1	12.4/12.3	23.4/23.1	18.2/18.1	12.4/12.3	23.4/23.1	18.2/18.1	12.4/12.3	23.4/23.1	18.2/18.1	12.4/12.3
ENT. WATER TEMP	"C	18.0	18.0	18.0	18.0	18.0	18.0	18.0	18.0	18.0	18.0	18.0	18.0		
LEAV. WATER TEMP	"C	26.0	-	-	26.0	-	-	26.0	-	-	26.0	-	-		
SUPPLY AIR		L/s				930			2300			2300			
OUTDOOR AIR		L/s				930			2300			2300			
DRAIN PIPE SIZE		Ømm				40			50			50			
CHW COIL		CONNECTION SIZE	Ømm		50	50	80	80	80	80	80	80	80		
		TYPE OF CONTROL VALVE	2W-P		2W-O/F	2W-P		2W-O/F	2W-P		2W-O/F	2W-P		2W-O/F	
BLOWER		EXTERNAL ST. PR.	Pa		500		600		600		600		600		
		APPROX.	KW		1.5		4.0		4.0		4.0		4.0		
		STARTER TYPE			EC Fan		EC Fan		EC Fan		EC Fan				
AIR FILTER		V / PH / Hz			400/3/50		400/3/50		400/3/50		400/3/50		400/3/50		
		TYPE			PF-2MF-3		PF-2MF-3		PF-2MF-3		PF-2MF-3		PF-2MF-3		
		MANOMETER	SET (S)		2		2		2		2		2		
		DIFFERENTIAL PRESSURE SWITCH FOR FILTER CLOG ALARM	SET (S)		2		2		2		2		2		
CDU TYPES		UNIT INTEGRATED - WATER COOLED UNIT (WCU), FIXED COMP REJECTS TO CHW CIRCUIT. INVERTER COMP REJECTS TO CHW CIRCUIT				UNIT INTEGRATED - WATER COOLED UNIT (WCU), FIXED COMP REJECTS TO CHW CIRCUIT. INVERTER COMP REJECTS TO CHW CIRCUIT			UNIT INTEGRATED - WATER COOLED UNIT (WCU), FIXED COMP REJECTS TO CHW CIRCUIT. INVERTER COMP REJECTS TO CHW CIRCUIT			UNIT INTEGRATED - WATER COOLED UNIT (WCU), FIXED COMP REJECTS TO CHW CIRCUIT. INVERTER COMP REJECTS TO CHW CIRCUIT			
FACE VELOCITY		1.8 m/s				1.8 m/s			1.8 m/s			1.8 m/s			
PHASE		PHASE I				PHASE II			PHASE III			PHASE IV			
ELECTRICAL PANEL BOARD NO.		TH-BKK02-02-01-MCP-026				TH-BKK02-02-07-MCP-(001,002,003)			TH-BKK02-02-07-MCP-004			TH-BKK02-02-07-MCP-005			
SERVE BY TES															

- | | | |
|----------------|---|--|
| NOTES : | <p>1. MAX. SUPPLY AIR TEMPERATURE SHALL BE THE CONDITION OF SUPPLY AIR WHICH IS MEASURED AT AIR TERMINAL OR AIR OUTLET. THE CONTRACTOR SHALL COMPENSATE THE HEAT GENERATED FROM FAN'S MOTOR TO ACHIEVE THAT DESIRED SUPPLY AIR TEMPERATURE.</p> <p>2. COOLING COIL FACE VELOCITY SHALL NOT EXCEED 2.5 m/s. AHU FAN OUTLET VELOCITY SHALL NOT EXCEEDING 12 m/s.</p> <p>3. WATER PRESSURE DROP OF COOLING COIL SHALL NOT EXCEED 45 kPa</p> <p>4. EXTERNAL STATIC PRESSURE OF BLOWER SHOWN IN SCHEDULE SHALL BE THE SUM OF ALL SYSTEM COMPONENT PRESSURE LOSSES EXCEPT COOLING COIL AND CASING OF AHU OR FCU.</p> <p>5. TYPE OF AHU & FCU</p> <p>5.1 FOR AHU :</p> <p>V-V = VERTICAL MOUNTED, VERTICAL DISCHARGE</p> <p>V-H = VERTICAL MOUNTED, HORIZONTAL DISCHARGE</p> <p>H-V = HORIZONTAL MOUNTED, VERTICAL DISCHARGE</p> <p>H-H : x = HORIZONTAL MOUNTED, HORIZONTAL DISCHARGE</p> <p>X</p> <p>S = SINGLE SKIN TYPE</p> <p>D = DOUBLE SKIN TYPE</p> | <p>6. TYPE OF CONTROL VALVE (PIBCV-PRESSURE INDEPENDENT BALANCING CONTROL VALVE)</p> <p>2W-OF = 2-WAY MOTORIZED VALVE ; ON-OFF TYPE</p> <p>2W-P = 2-WAY MOTORIZED VALVE ; PROPORTIONAL TYPE</p> <p>3W-OF = 3-WAY MOTORIZED VALVE ; ON-OFF TYPE</p> <p>7. TYPE OF AIR FILTERS</p> <p>7.1 TYPE "FF-1" PRE FILTER, PANEL FILTER, POLYESTER SYNTHETIC FIBER, 9mm.</p> <p>7.2 TYPE "FF-2" PRE FILTER, PANEL FILTER, POLYESTER SYNTHETIC FIBER, 30mm. EU2 RATING OR MERV 4</p> <p>7.3 TYPE "2" PRE FILTER, PANEL FILTER, GLASS FIBER, 50mm. EU3 RATING OR MERV 5</p> <p>7.4 TYPE "FF-4" PRE FILTER, EXTENDED SURFACE PLATED TYPE PANEL FILTER, GLASS FIBER, 100mm. EU6 RATING OR MERV 8</p> <p>7.5 TYPE "FF-5" PRE FILTER, EXTENDED SURFACE PLATED TYPE PANEL FILTER, GLASS FIBER, 100mm. EU6 RATING OR MERV 8</p> <p>7.6 TYPE "MF-1" MEDIUM FILTER, EXTENDED SURFACE POCKET TYPE MEDIUM FILTER, GLASS FIBER, EU6 RATING OR MERV 8</p> <p>7.7 TYPE "MF-2" MEDIUM FILTER, EXTENDED SURFACE POCKET TYPE MEDIUM FILTER, GLASS FIBER, 550mm, EU7 RATING OR MERV 9</p> <p>7.8 TYPE "MF-3" MEDIUM FILTER, EXTENDED SURFACE PLATED TYPE MEDIUM FILTER, GLASS FIBER EU7 RATING OR MERV 9</p> |
| | <p>* SELECTION FOR 0.5 WCMH MAXIMUM FAN POWER RATING</p> | |

CHILLERS SCHEDULE (BY LLE CONTRACTOR - FOR INFORMATION ONLY)

REQUIRED PERFORMANCES		Unit Data Each	Unit Data Each	Unit Data Each	Unit Data Each
UNIT NO.		TH-BKK2-02-06-CH-01 to 03(Duty 2,St by 1) (Phase 1)	TH-BKK2-02-06-CH-04 (Phase 2)	TH-BKK2-02-06-CH-05 (Phase 3)	TH-BKK2-02-06-CH-06 (Phase 4)
QUANTITY	SET (S)	3	1	1	1
CHILLER ARRANGEMENT		Single Unit Multi-Stage Single Compressor	Single Unit Multi-Stage Single Compressor	Single Unit Multi-Stage Single Compressor	Single Unit Multi-Stage Single Compressor
TYPE OF COMPRESSOR		Centrifugal with oil lubricant bearing or Oil Free Bearing	Centrifugal with oil lubricant bearing or Oil Free Bearing	Centrifugal with oil lubricant bearing or Oil Free Bearing	Centrifugal with oil lubricant bearing or Oil Free Bearing
TYPE OF CONDENSER		Water Cooled	Water Cooled	Water Cooled	Water Cooled
TYPE OF REFRIGERANT		R-1233 xtd(E) or R-514A or 1234ZE	R-1233 xtd(E) or R-514A or 1234ZE	R-1233 xtd(E) or R-514A or 1234ZE	R-1233 xtd(E) or R-514A or 1234ZE
COOLING CAPACITY	kW(REFRIGERATION)	5627 kW Ref (1600 RT)	5627 kW Ref (1600 RT)	5627 kW Ref (1600 RT)	5627 kW Ref (1600 RT)
CHILLED WATER FLOW RATE	L/s	170 L/s (1.67 gpm/ton)	170 L/s (1.67 gpm/ton)	170 L/s (1.67 gpm/ton)	170 L/s (1.67 gpm/ton)
CHILLED WATER TEMP. OUT/IN	°C	18.0/26.0	18.0/26.0	18.0/26.0	18.0/26.0
CONDENSER WATER FLOW RATE	L/s	302	302	302	302
CONDENSER WATER TEMP. OUT/IN	°C	38.7/33.2 (extreme), 36.7/31.2 (Normal)	38.7/33.2 (extreme), 36.7/31.2 (Normal)	38.7/33.2 (extreme), 36.7/31.2 (Normal)	38.7/33.2 (extreme), 36.7/31.2 (Normal)
COOLER FOULING FACTOR (Based on ARI 550/590)	m2.0CKW	0.0176	0.0176	0.0176	0.0176
CONDENSER FOULING FACTOR (Based on ARI 550/590)	m2.0CKW	0.044	0.044	0.044	0.044
MAX PRESSURE DROP FOR COOLER	kPa	45 kPa(15 Ft Wg.)	45 kPa(15 Ft Wg.)	45 kPa(15 Ft Wg.)	45 kPa(15 Ft Wg.)
MAX PRESSURE DROP FOR CONDENSER	kPa	60 kPa(20 Ft Wg.)	60 kPa(20 Ft Wg.)	60 kPa(20 Ft Wg.)	60 kPa(20 Ft Wg.)
COOLER WORKING PRESSURE	kPa	1034 KPa.(150 Paig.)	1034 KPa.(150 Paig.)	1034 KPa.(150 Paig.)	1034 KPa.(150 Paig.)
CONDENSER WORKING PRESSURE	kPa	1034 KPa.(150 Paig.)	1034 KPa.(150 Paig.)	1034 KPa.(150 Paig.)	1034 KPa.(150 Paig.)
NO. OF PASS OF COOLER		2 Pass	2 Pass	2 Pass	2 Pass
NO. OF PASS OF CONDENSER		2 Pass	2 Pass	2 Pass	2 Pass
EE CONSUMPTION	kW	640.0	640.0	640.0	640.0
COEFFICIENT OF PERFORMANCE (COP) kWREF / kWEE	100% Load	See LLE Chiller Equipment Data Sheet	See LLE Chiller Equipment Data Sheet	See LLE Chiller Equipment Data Sheet	See LLE Chiller Equipment Data Sheet
TYPE OF COMPRESSOR MOTOR STARTER		VSD	VSD	VSD	VSD
ELECTRICAL SUPPLY	V/Ph/Hz.	400/3/50	400/3/50	400/3/50	400/3/50
ELECTRICAL PANEL BOARD NO.		TH-BKK2-02-MSS801 to 03	TH-BKK2-02-MSS804	TH-BKK2-02-MSS806	TH-BKK2-02-MSS808
PHASING		Phase I	Phase II	Phase III	Phase IV

NOTE :
1. EACH CHILLER TO INCLUDE AUTOMATIC BALL FILTRATION SYSTEM
2. CHILLER PERFORMANCE BASED ON ZERO TOLERANCE (REFER AHR)

COOLING TOWERS SCHEDULE (BY LLE CONTRACTOR - FOR INFORMATION ONLY)

REQUIRED PERFORMANCES	UNIT DATA (EACH)	UNIT DATA (EACH)	UNIT DATA (EACH)	UNIT DATA (EACH)
UNIT NO.	TH-BKK2-02-07-CT-001 to 003	TH-BKK2-02-07-CT-004	TH-BKK2-02-07-CT-005	TH-BKK2-02-07-CT-006
QUANTITY Set(s)	3 Cooling Tower(2-Cells Cooling Tower)(Qty 2, St by 1)	1 Cooling Tower(2-Cells Cooling Tower)	1 Cooling Tower(2-Cells Cooling Tower)	1 Cooling Tower(2-Cells Cooling Tower)
TYPE OF COOLING TOWER	Induce Draft Cross Flow-Super Low Noise	Induce Draft Cross Flow-Super Low Noise	Induce Draft Cross Flow-Super Low Noise	Induce Draft Cross Flow-Super Low Noise
TYPE OF FAN	Propeller Fan Gear Drive or Direct Drive	Propeller Fan Gear Drive or Direct Drive	Propeller Fan Gear Drive or Direct Drive	Propeller Fan Gear Drive or Direct Drive
CONDENSER WATER FLOW RATE (L/s)	302 L/s per cooling tower(151 L/s per cell)	302 L/s per cooling tower(151 L/s per cell)	302 L/s per cooling tower(151 L/s per cell)	302 L/s per cooling tower(151 L/s per cell)
CONDENSER WATER TEMP OUTIN (°C)	38.7/33.2 (extreme), 36.7/31.2 (Normal)	38.7/33.2 (extreme), 36.7/31.2 (Normal)	38.7/33.2 (extreme), 36.7/31.2 (Normal)	38.7/33.2 (extreme), 36.7/31.2 (Normal)
AMBIENT WET BULB TEMPERATURE FOR SELECTION (°CWB)	31.4 °CWB (extreme), 28.4 °CWB (Normal)	31.4 °CWB (extreme), 28.4 °CWB (Normal)	31.4 °CWB (extreme), 28.4 °CWB (Normal)	31.4 °CWB (extreme), 28.4 °CWB (Normal)
SIDE STREAM FLOWING (L/S)	30	30	30	30
MAXIMUM FAN MOTOR (kW)	22.0 kW per cell x 2 cells per Cooling Tower	22.0 kW per cell x 2 cells per Cooling Tower	22.0 kW per cell x 2 cells per Cooling Tower	22.0 kW per cell x 2 cells per Cooling Tower
MOTOR SPEED (RPM)	1450	1450	1450	1450
TYPE OF MOTOR STARTER	VSD with Motor IE 4	VSD with Motor IE 4	VSD with Motor IE 4	VSD with Motor IE 4
ELECTRICAL SUPPLY (V/PH/Hz)	400/3/50	400/3/50	400/3/50	400/3/50
NUMBER OF MOTOR STAGE	SINGLE	SINGLE	SINGLE	SINGLE
ELECTRICAL PANEL BOARD NO.	TH-BKK02-02-07-MCC-01(019.020.021)	TH-BKK02-02-07-MCC-022	TH-BKK02-02-07-MCC-023	TH-BKK02-02-07-MCC-024
PHASING	Phase I	Phase II	Phase III	Phase IV

ABBREVIATION

NOTE: 1.THE CONTRACTOR SHALL APPLY THE MAXIMUM CONDENSER WATER FLOW RATE 1.25 TIMES OF NORMAL CONDENSER WATER FLOW RATE FOR THE DESIGN OF HOT WATER & COLD WATER DISTRIBUTION SYSTEM IN ORDER TO PREVENT THE OVERFLOW OF WATER

2.ALL COOLING TOWER SHALL BE EQUIPPED WITH DRIFT ELIMINATOR.

3. EACH COOLING TOWER SHALL BE PROVIDED WITH 1 NO. CHEMICAL TREATMENT SYSTEM