

## REQUEST FOR INFORMATION (RFI)

PROJECT :	BKK2	R.F.I. NO. :	523213-01-RFI-AR-0012
TO :	CTA	ATTENTION :	CTA
SUBMITTED DATE:	20-Jan-26	NEED REPLY BY DATE :	27-Jan-26

SUBMISSION OF : ☒ Q&A ☐ Drawing ☒ Document ☐ Others (as specified below)

SUBJECT : Request for Confirmation - Floor Tiles Size, Start Point, Layout and Orientation for Security Room and Reception Hall 1st FL

Total Page (s) : 2 (Including this page)


FUNCTION : ☐ Structural (ST) ☐ Electrical & Communication (EL) ☐ Mechanical (ME) ☐ Vertical Transport (VT)


☒ Achitectural (AR) ☐ Fire Protection (FI) ☐ Hydraulic & Sanitary (HY) ☐ Other (O)

## (1) CONTRACTOR REQUEST FOR INFORMATION :

Floor Finishes F1 in ID Finishes Schedule stated 600x1200mm size floor tiles but it shows 600x600mm for reception hall in layout plan.

GC needs to follow design drawing to provide tile starting point for installation and please confirm the tile layout, orientation and size.



Requested by :   
Engineering Manager

Reviewed by :   
Project Manager

## (2) ATTN : Commtech Asia (Thailand)

☐ For Approval ☐ See Note ☒ Please Clarify

Note : Aurecon to confirm the tile size

From : GAA Group  
By :   
Name / Position : Mr. Itsarate Trachuengtong  
Project Manager  
Date : 20-Jan-26  
Reviewed By :   
Name / Position : Finlay Coady  
Sr. Project Manager  
Date : 30th January 2026

## (3) ATTN : AURECON

☐ For Approval ☐ See Note ☐ Please Clarify


Note : SLA: Please refer to the notes in the attached markup.

From : Commtech Asia (Thailand)  
By :  
Name / Position : (  
Date :  
Reviewed By : Tarkoon Suwansukhum  
AURECON  
Name / Position : Tarkoon S / Architect  
Date : 3 February 2026

## (4) ATTN : STT GDC

☒ Clarification only ☐ Not Approved  
☐ Approved for proceeding work  
☐ Approved with comments, proceeding work in compliance with comments  
☐ Approved with comments, not for proceeding work and need to re-submit


Note : Please follow consultant's response.

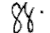From : AURECON  
By :  
Name / Position : (  
Date :  
Reviewed By : STT GDC   
Name / Position : Sirawit Thepsuwan VP PMO  
Date : 6 Feb 2026



Floor Finishes F1 in ID Finishes Schedule stated 600x1200mm size floor tiles but it shows 600x600mm for reception hall in layout plan.

GC needs to follow design drawing to provide tile starting point for installation and please confirm the tile layout, orientation and size.

SLA: Floor finish F1 and tile set out point to follow ID drawing AR-4505 (see sheet 2).

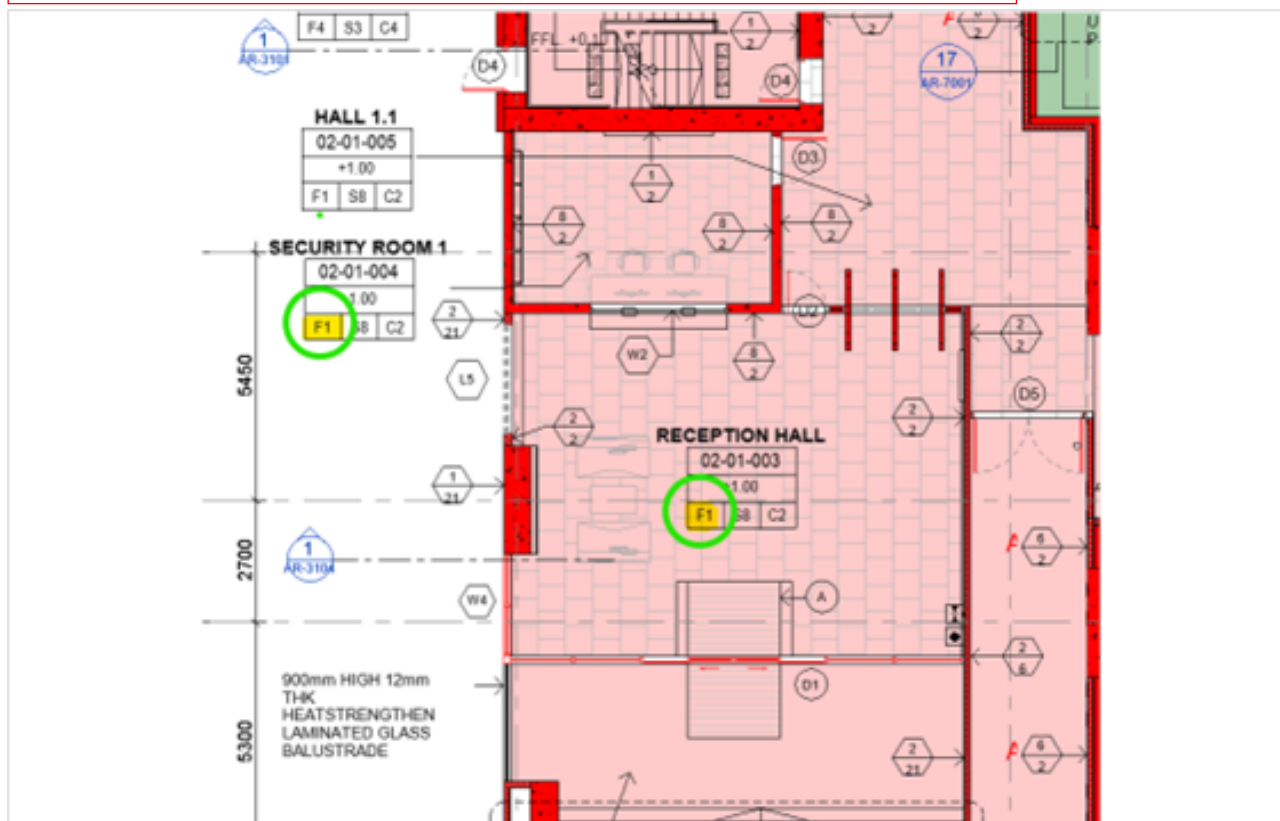


FLOOR FINISH				
FLOOR NO.	LOCATION	DESCRIPTION	IMAGE	SPECIFICATION
001	TECHNICAL ASSISTANCE CENTER	FLOOR TILE		CARPET TILE FLOW STRIPESS DARK GREY COLOR CODE : 2052008 LANDSLIDE.
002 [AR CODE : F1]	LOBBY	FLOOR TILE		HOMOGENOUS CERAMIC TILE MATTE FINISHES GREY COLOR CODE : EDM1941 (R10) SIDE 600X1200 mm.
003 [AR CODE : F7]	LOBBY	FLOOR TILE		HOMOGENOUS CERAMIC TILE MATTE FINISHES LIGHT GREY COLOR CODE : EDM1940 (R10) SIDE 600X1200 mm.

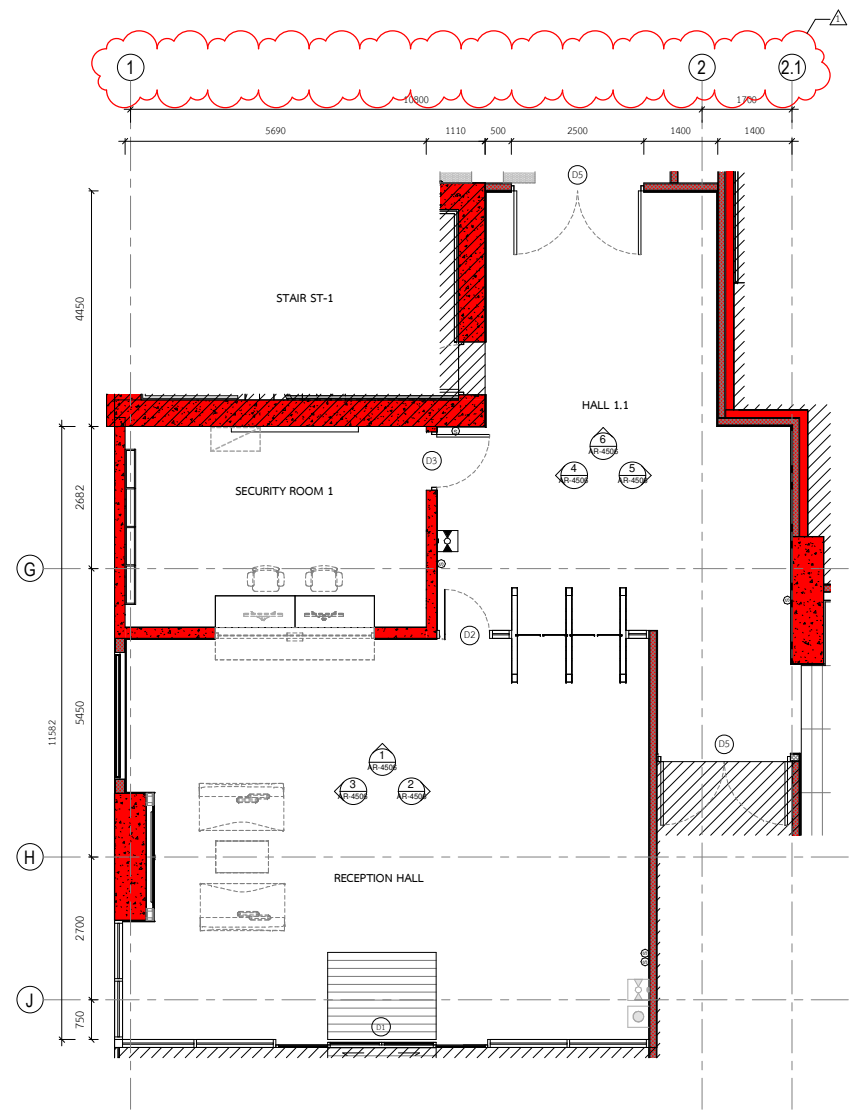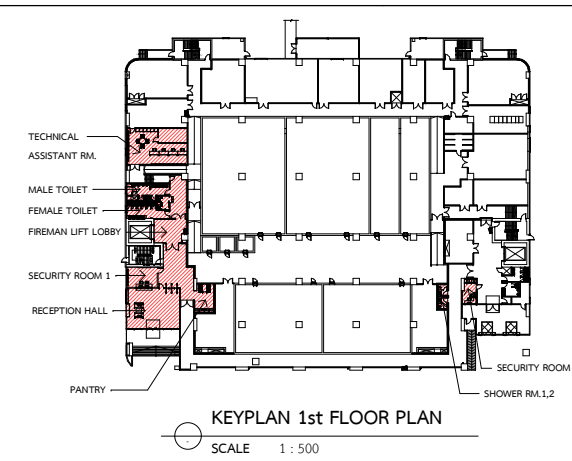

1 MAIN ENTRANCE LOBBY FURNITURE&ELECTRICAL  
SCALE 1 : 50



2 MAIN ENTRANCE LOBBY FLOOR&WALL FINISHES  
SCALE 1 : 50

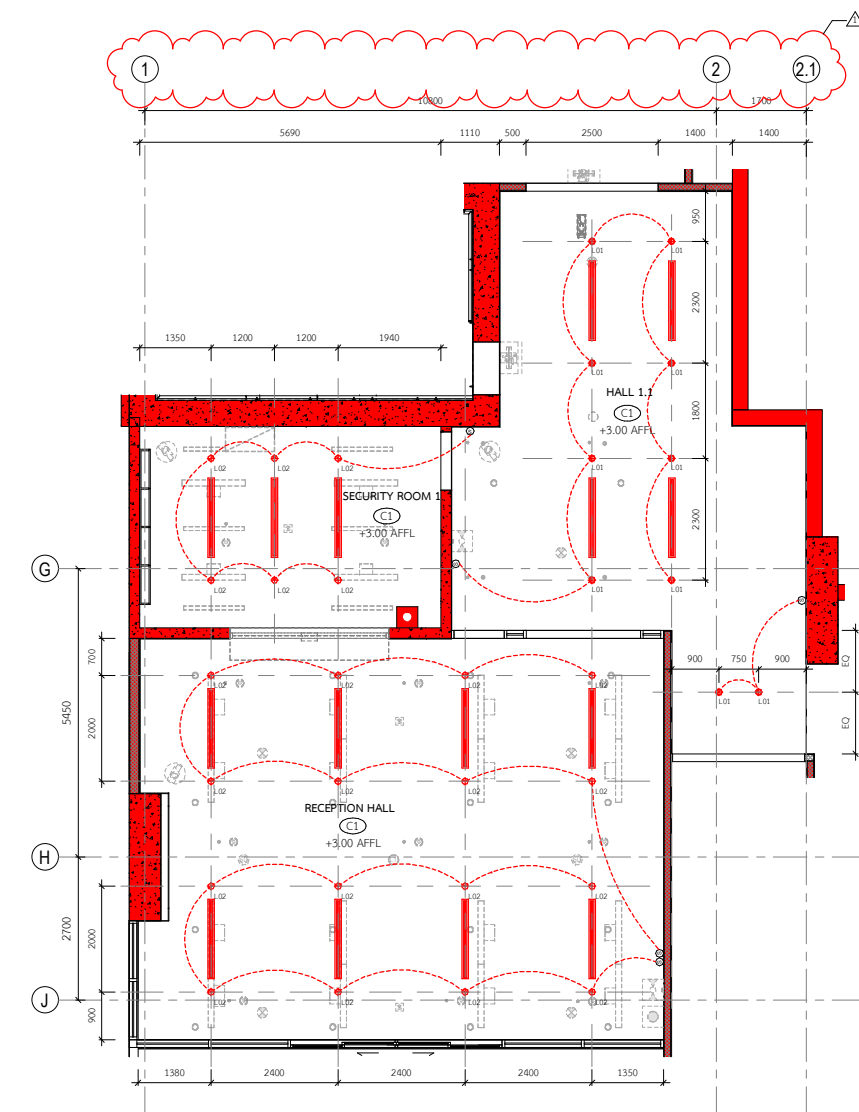

3 MAIN ENTRANCE LOBBY REFLECTED CEILING  
SCALE 1 : 50

CLIENT			
STTelemedia Global Data Centres STT GDC (THAILAND) CO., LTD. 944 Mitotown Office Tower, 22nd-23rd Floor Rama 4 Road, Wangmai, Pathumwan, Bangkok 10330			
ENGINEER			
aurecon www.aurecongroup.com AURECON CONSULTING (THAILAND) CO., LTD. 89 AIA Capital Center Building, 21st Floor, Unit 2104-2107 Ratchadapisek Road, Dindaeng, Bangkok 10000			
STRUCTURAL REVIEWER			
สมชาย เกษมศิริรักษ์	ร.ร. 1754		
STRUCTURAL			
วิวัฒน์ วัฒนศิริรักษ์	ร.ร. 1488		
อภิชัย วัฒนศิริรักษ์	ร.ร. 9229		
อภิชัย วัฒนศิริรักษ์	ร.ร. 64414		
SAFETY AND FIRE PROTECTION			
อภิชัย วัฒนศิริรักษ์	ร.ร. 209		
อภิชัย วัฒนศิริรักษ์	ร.ร. 438		
อภิชัย วัฒนศิริรักษ์	ร.ร. 3502		
อภิชัย วัฒนศิริรักษ์	ร.ร. 3907		
อภิชัย วัฒนศิริรักษ์	ร.ร. 4891		
อภิชัย วัฒนศิริรักษ์	ร.ร. 6968		
ELECTRICAL AND COMMUNICATIONS			
อภิชัย วัฒนศิริรักษ์	ร.ร. 1297		
อภิชัย วัฒนศิริรักษ์	ร.ร. 6721		
อภิชัย วัฒนศิริรักษ์	ร.ร. 6687		
อภิชัย วัฒนศิริรักษ์	ร.ร. 53962		
อภิชัย วัฒนศิริรักษ์	ร.ร. 59400		
MECHANICAL ENGINEER			
อภิชัย วัฒนศิริรักษ์	ร.ร. 648		
อภิชัย วัฒนศิริรักษ์	ร.ร. 4976		
อภิชัย วัฒนศิริรักษ์	ร.ร. 5005		
ARCHITECTS			
StevenLeach Partners in creative solutions STEVEN LEACH ARCHITECTS LIMITED บริษัท สตีเวน เลอช อภิชัย วัฒนศิริรักษ์ จำกัด 42 อาคารเฉลิมพระเกียรติฯ 10 ซอยสุขุมวิท ถนนสุขุมวิท แขวงคลองเตย เขตคลองเตย กรุงเทพมหานคร 10130			
ARCHITECT			
อภิชัย วัฒนศิริรักษ์	ร.ร. 603		
อภิชัย วัฒนศิริรักษ์	ร.ร. 3222		
REV			
1	02/02/04	FOR CONSTRUCTION	TS
2	17/03/03	FOR CONSTRUCTION	TS
REV	DATE	DESCRIPTION	APP
SCALE		SIZE	
As indicated		A0	
DRAWN		APPROVED	
CC		DATE	17.10.25
DESIGNED		SLA	
SLA		TS	
CHECKED		TS	
TS			
PROJECT			
อาคารศูนย์เก็บข้อมูลอิเล็กทรอนิกส์ สูง 8 ชั้น จำนวน 1 หลัง ขอทราบค่าเช่า 28 ธันวาคม 2563 และขอทราบค่าเช่า บาทละ 100,000 บาท			
TITLE			
MAIN ENTRANCE LOBBY PLAN			
DRAWING NUMBER			
523213 - 02 - DRG - AR-4505			