

**REQUEST FOR INFORMATION (RFI)**

PROJECT :	BKK2	R.F.I. NO. :	523213-01-RFI-AR-0035
TO :	CTA	ATTENTION :	CTA
SUBMITTED DATE:	21-Jan-26	NEED REPLY BY DATE :	28-Jan-26

SUBMISSION OF :	<input checked="" type="checkbox"/> Q&A	<input checked="" type="checkbox"/> Drawing	<input checked="" type="checkbox"/> Document	<input type="checkbox"/>	Others (as specified below)
SUBJECT : Request for Information - Confirm the type of the Tile - From Catalog, SE 206 is Carpet Tile.					

Total Page (s) : 4 (Including this page)

FUNCTION :	<input type="checkbox"/> Structural (ST)	<input type="checkbox"/> Electrical & Communication (EL)	<input type="checkbox"/> Mechanical (ME)	<input type="checkbox"/> Vertical Transport (VT)
	<input checked="" type="checkbox"/> Architectural (AR)	<input type="checkbox"/> Fire Protection (FI)	<input type="checkbox"/> Hydraulic & Sanitary (HY)	<input type="checkbox"/> Other (O)

**(1) CONTRACTOR REQUEST FOR INFORMATION :**

Could you please reconfirm the floor type? According to the Armstrong Flooring catalogue, this specific material code refers to Carpet Tile, not Vinyl Tile.

Requested by : 	Reviewed by : 
Engineering Manager	Project Manger

**(2) ATTN : Commtech Asia (Thailand)** For Approval     See Note     Please Clarify

From : GAA Group

By : Name / Position Mr. Itsarate Trachuengtong/  
Project Manager

Date : 21-Jan-26

Note :

Aurecon to confirm the tile type

Reviewed By : Commtech Asia (Thailand)

Name / Position Finlay Coady

Date : Sr. Project Manager  
30th January 2026**(3) ATTN : AURECON** For Approval     See Note     Please Clarify

From : Commtech Asia (Thailand)

By :

Name / Position ( )

Date :

Note :

SLA: VT01 is a vinyl tile.

Reviewed By : Tarkoon Suwansukhum  
AURECON

Name / Position ( Tarkoon S / Architect )

Date : 3 February 2026

**(4) ATTN : STT GDC**

- Clarification only     Not Approved
- Approved for proceeding work
- Approved with comments, proceeding work in compliance with comments
- Approved with comments, not for proceeding work and need to re-submit

From : AURECON

By :

Name / Position ( )

Date :

Note :

Please follow SLA's response

Reviewed By : STT GDC

Name / Position Sirawit Thepsuwan VP PMO

Date : 6 Feb 2026

CC :

 STT GDC AURECON Commtech Asia  
(Thailand) GAA OTHERS.....

## FINISHING SCHEDULE

FLOOR FINISH					WALL FINISH						
FLOOR NO.	LOCATION	DESCRIPTION	IMAGE	SPECIFICATION	SUPPLIER	WALL NO.	LOCATION	DESCRIPTION	IMAGE	SPECIFICATION	SUPPLIER
■	TECHNICAL ASSISTANCE CENTER	FLOOR TILE		CARPET TILE FLOW STRIPES DARK GREY COLOR CODE : 2052008 LANDSLIDE.	VISPAC (KHUN EIBB 0819228151)	▲		PAINT OR SPRAY PAINT FINISH		SUPERSHIELD DURACLEAN A+ SHADE:N366 (GRAY) SEMIGLOSS FINISHED	PICHAPAK KAMOLSUPACHAO T: +66 81 170 6671,+66 96 423 2241 E: PICHAPAK_K@TOAGROUP.COM
[AR CODE : F1]	LOBBY	FLOOR TILE		HOMOGENOUS CERAMIC TILE MATTE FINISHES GREY COLOR CODE : EDM1941 (R10) SIDE 600X1200 mm.	ELEGANT DÉCOR TILE (KHUN NALIN 0952299239)	▲		PAINT OR SPRAY PAINT FINISH		SUPERSHIELD DURACLEAN A : N6366 (GRAY) MATT FINISHED	PICHAPAK KAMOLSUPACHAO T: +66 81 170 6671,+66 96 423 2241 E: PICHAPAK_K@TOAGROUP.COM
[AR CODE : F7]	LOBBY	FLOOR TILE		HOMOGENOUS CERAMIC TILE MATTE FINISHES LIGHT GREY COLOR CODE : EDM1940 (R10) SIDE 600X1200 mm.	ELEGANT DÉCOR TILE (KHUN NALIN 0952299239)	▲		PAINT FINISH		SUPERSHIELD DURACLEAN A : K7034 (TOUCH OF GRAY) SEMI-GLOSS FINISHED	PICHAPAK KAMOLSUPACHAO T: +66 81 170 6671,+66 96 423 2241 E: PICHAPAK_K@TOAGROUP.COM
[AR CODE : F7]	TOILET/SHOWER /CHANGING ROOM/JANITOR	FLOOR TILE		HOMOGENOUS CERAMIC TILE MATTE FINISHES DARK GREY COLOR CODE : EDM1942 (R10) SIDE 300X600 mm.	ELEGANT DÉCOR TILE (KHUN NALIN 0952299239)	▲		LAMINATE FINISH		LAMINATE WHITE COLOR FORMICA WHITE COLOR (9244 CLASSIC WHITE)	K. OUM 061-402 8391
[AR CODE : F7]	PANTRY ROOM	FLOOR TILE		WOODEN CERAMIC TILE IN MATTE FINISHES CODE : EDM1191 (R10) SIDE 200X1200 mm.	ELEGANT DÉCOR TILE (KHUN NALIN 0952299239)	▲		LAMINATE FINISH		LAMINATE WOODEN FINISH FORMICA NATURAL SILK OAK (8255)	K. OUM 061-402 8391
[AR CODE : F7]	SECURITY ROOM	FLOOR TILE		VINYL TILE NATURAL CREATION WYMANLAND COLLECTION CODE : SE 206 SANDSTONE	VISPAC (ARMSTRONG FLOORING) (KHUN EIBB 0819228151)	▲		STONE FINISH		G633 GRANITE LEATHERED FINISH LIGHT GREY TONE	EMPIRE STONE (SALE@EMPIRE STONE.CO.TH)
						▲		STONE FINISH		G633 GRANITE HONED FINISH LIGHT GREY TONE	EMPIRE STONE (SALE@EMPIRE STONE.CO.TH)
						▲		SPECIAL FINISH		5MM. THK WPC STAINLESS WALL PANEL COMPOSITE CODE: YTJS06	THE LEGACY GROUP (K.PASSANUPAK)+6690 949 7222 E-mail: ytjs05@gmail.com
+		START POINT				▲	ENTRANCE LOBBY	SPECIAL FINISH		PRESERVED GREEN WALL: PRESERVED MOSS 50% + PRESERVED FOLIAGE 50%	ZILLION KHUN TANGMO 082-6496061
	SKIRTING FINISH					▲		SPECIAL FINISH		12 MM. THK ACOPANEL (AP12) COLOR	LIGHT GREY @ FELTECH (K.NUSARA) TEL:+6685 150 9947 E:nusara@feltech.co.th
	SKIRT NO.	LOCATION	DESCRIPTION	IMAGE	SPECIFICATION	▲	[AR CODE : W4]	TOILET/ SHOWER		MATTE FINISHES DARK GREY COLOR CODE : EDT0007 (R10) SIDE 300X600 mm.	ELEGANT DÉCOR TILE (KHUN NALIN 0952299239)
	CEILING NO.	LOCATION	DESCRIPTION	IMAGE	SPECIFICATION	▲				U SHAPE PROFILE 5 MM. ALUMINUM CODE : AW05 COLOR : BLACK 519	ALLOY (K.BENZ) TEL:+6682 486 3820 E:Chidshanok@alloysolutions.asia
C1	LIFT LOBBY, ENTRANCE LOBBY, HALL, SECURITY RM. 2, TOILET, SHOWER	GYPSUM BOARD CEILING		9mm. THK MOISTURE RESISTANT GYPSUM BOARD SET PLASTER W/ MOISTURE RESISTANT PAINT FINISH CODE : P02	SIAM GYPSUM SCG	▲				1.2 MM. THK. STAINLESS STEEL CODE : NCSD15-SD COLOR : SILVER SANDING	Name : Sayumporn Aksonat T:+66 96-8306181 E:salesmanager@mitiqlad.com
C2	PANTRY, TAC	GYPSUM BOARD CEILING		600 X 600 MM. T-BAR CEILING ACOUSTIC BOARD CODE : P02	SIAM GYPSUM SCG	▲	GENERAL				
L01	PANTRY, LIFT LOBBY, HALL, SECURITY RM.2 FRONT HOUSE TOILET, SHOWER RM.			PRODUCT IR30866-1/GU10/WH/WH RECESSED ADJUSTABLE DOWNLIGHT ALUMINIUM HOUSING WITH TRIM RING FINISHED IN POWDER COATED WHITE/WHITE REFLECTOR BEAM ANGLE 36D CCT 4000K	LIGHT UP TOTAL SOLUTION PUBLIC COMPANY LIMITED. คุณ จิรภัท 097-2696212 อีเมล jirapat @_lightuptotal.co.th	●					
L02	ENTRANCE LOBBY, SECURITY RM. 1			PRODUCT IR30866-1/GU10/WH/WH RECESSED ADJUSTABLE DOWNLIGHT ALUMINIUM HOUSING WITH TRIM RING FINISHED IN POWDER COATED WHITE/WHITE REFLECTOR 1 X COB LED 12W 1200LM BEAM ANGLE 36D CCT 4000K	LIGHT UP TOTAL SOLUTION PUBLIC COMPANY LIMITED. คุณ จิรภัท 097-2696212 อีเมล jirapat @_lightuptotal.co.th	●					
L03	TAC			PRODUCT IC30955-40W/40/120/6060 RECESSED Panel Light Aluminium housing WHITE LED 40W 4600lm CRI80 BEAM ANGLE 120D CCT 4000K	LIGHT UP TOTAL SOLUTION PUBLIC COMPANY LIMITED. คุณ จิรภัท 097-2696212 อีเมล jirapat @_lightuptotal.co.th	●					
LED01				PRODUCT IL10027-40/20 LED STRIP LIGHT LED STRIP LIGHT 14.4W/M CR190 SMD2835-120LEDS/M 24V 1380LM/M. BEAM ANGLE 120D CCT 4000K	LIGHT UP TOTAL SOLUTION PUBLIC COMPANY LIMITED. คุณ จิรภัท 097-2696212 อีเมล jirapat @_lightuptotal.co.th	●					
LED02				PRODUCT IL10026-40 LED STRIP LIGHT LED STRIP LIGHT 9.6W/M CR190 SMD2216-120LEDS/M 912LM/M BEAM ANGLE 120D CCT 4000K	LIGHT UP TOTAL SOLUTION PUBLIC COMPANY LIMITED. คุณ จิรภัท 097-2696212 อีเมล jirapat @_lightuptotal.co.th	●					
J		OUTLET TO BE MOUNTED ON JOINERY OR FURNITURE				●					
		CURCIT LINE				●					
○		SWITCH				●					
—		LINEAR A/C AIR GRILLE				●					
□		SUPPLY AIR GRILLE (SQUARE TYPE)				●					

POWER OUTLET LEGEND			
●	SINGLE POWER OUTLET	●	DOUBLE POWER OUTLET (RED) UPS POWER
●	DOUBLE POWER OUTLET	●	DATA OUTLET
●	TELEPHONE OUTLET	●	TV OUTLET
●	GROUP OF OUTLET	●	LOAD CENTER
●	CONTROL PANEL	●	CARD READER
●	PUSH BUTTON	●	WIRELESS LAN
H+.....	OUTLET INSTALLATION HEIGHT	C	OUTLET TO BE MOUNTED ON CEILING
J	OUTLET TO BE MOUNTED ON JOINERY OR FURNITURE		

NOTE : SWITCH HEIGHTS			
FFL	150	20	FFL
FFL	100	20	FFL
FFL	80	20	FFL
FFL	60	20	FFL
FFL	40	20	FFL
FFL	20	20	FFL

NOTE: UNLESS OTHERWISE NOTED  
 1. ALL COLOUR AND FINISHES OF INTERIOR FIXTURE WILL BE SPECIFIED BY INTERIOR DESIGNER  
 2. ALL SWITCHES AND SOCKET WILL BE PANASONIC OR EQUIVALENT

CLIENT	ST Telemedia Global Data Centres
	STT GDC (THAILAND) CO., LTD.
	944 Mittown Office Tower, 22nd-23rd Floor
	Rama 4 Road, Wangmai, Pathumwan, Bangkok 10330
ENGINEER	aurecon
	www.aurecongroup.com
	AURECON CONSULTING (THAILAND) CO., LTD.
	89 AIA Capital Center Building, 21st Floor, Unit 2104-2107
	Ratchadaphisek Road, Dindang, Dusit, Bangkok 10400
STRUCTURAL REVIEWER	STRUCTURAL REVIEWER
	สถาปัตย์ เชิงวิศวกรรม กม. 1754
MECHANICAL AND COMMUNICATIONS	MECHANICAL AND COMMUNICATIONS
	วิศวกร สถาปัตย์และเครื่องกล กม. 1488
	วิศวกร โทรทัศน์และเครื่องเสียง กม. 9229
	วิศวกร คอมพิวเตอร์ กม. 6614
ARCHITECT AND DESIGNER	ARCHITECT AND DESIGNER
	สถาปัตย์ และดีไซน์เนอร์ กม. 209
	สถาปัตย์และเครื่องเสียง กม. 438
	สถาปัตย์ ช่างไฟฟ้า กม. 3502
	สถาปัตย์ ช่างประปา กม. 3907
	สถาปัตย์ ช่างก่อสร้าง กม. 4891
	สถาปัตย์ ช่างเครื่องจักร กม. 6968
ELECTRICAL AND COMMUNICATIONS	ELECTRICAL AND COMMUNICATIONS
	แม่บ้าน ช่างไฟฟ้า กม. 1297
	แม่บ้าน ช่างไฟฟ้าและเครื่องเสียง กม. 6721
	แม่บ้าน ช่างประปา กม. 6447
	แม่บ้าน ช่างก่อสร้างและเครื่องจักร กม. 5392
	บุญเดชา ช่างเครื่องจักร กม. 59400
MECHANICAL ENGINEER	MECHANICAL ENGINEER
	สุวัฒน์ สถาปัตยกรรม กม. 848
	นาย ช่างประปา กม. 4976
	นาย ช่างก่อสร้าง กม. 5005
ARCHITECT	ARCHITECT
	บริษัท สถาปัตย์และดีไซน์เนอร์ กม. 603
	บริษัท สถาปัตย์และเครื่องเสียง กม. 3222
STEVEN LEACH	STEVEN LEACH
	บริษัท สถาปัตย์และดีไซน์เนอร์ กม. 603
	บริษัท สถาปัตย์และเครื่องเสียง กม. 3222
PROJECT	PROJECT
	อาคารสำนักงานชั้น 10 ขนาด 1000 ตร.ม. จำนวน 1 ชั้น สำหรับสำนักงานใหญ่
	ขนาดพื้นที่ 25 ตร.ม. สำหรับห้องน้ำ ห้องน้ำ จำนวน 1 ห้อง
TITLE	TOILET ENLARGE ROOM DETAILS
DRAWING NUMBER	DRAWING NUMBER
REV 1	REV 1
DATE 17/10/25	DATE 17/10/25
SCALE 1:50	SCALE 1:50
SIZE A0	SIZE A0
DRAWN CC	DRAWN CC
DESIGNED SLA	DESIGNED SLA
CHECKED TS	CHECKED TS
APPROVED SLA	APPROVED SLA

**Armstrong**Flooring™

MERIDA AVENUE™

**CARPET  
TILE**

## MERIDA AVENUE™

### STONE



SE 200  
457.2mmx914.4mm 457.2mmx457.2mm  
Fog Sand




TS 118  
457.2mmx914.4mm  
Terrazzo charm



SE 201  
457.2mmx914.4mm 457.2mmx457.2mm  
Temple Black



SE 207  
457.2mmx914.4mm 457.2mmx457.2mm  
Cream Jade

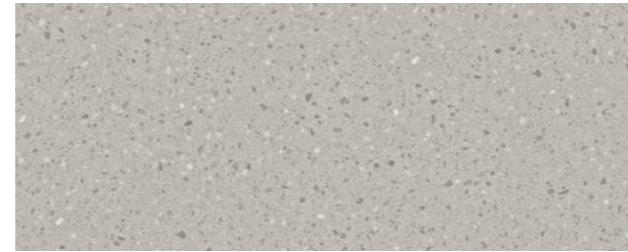

TS 111  
457.2mmx914.4mm  
Terrazzo source



TS 109  
457.2mmx914.4mm  
Rockgrey



SE 204  
457.2mmx914.4mm 457.2mmx457.2mm  
Beige Gold



TS 110  
457.2mmx914.4mm  
Rockgold



Carpet Tile not Vinyl Tile, Please confirm.

SLA: We confirmed it is a vinyl tile.