

REQUEST FOR INFORMATION (RFI)

PROJECT :	BKK2	R.F.I. NO. :	523213-01-RFI-AR-0024
TO :	CTA	ATTENTION :	CTA
SUBMITTED DATE:	19-Jan-26	NEED REPLY BY DATE :	26-Jan-26

SUBMISSION OF :	<input checked="" type="checkbox"/> Q&A	<input type="checkbox"/> Drawing	<input type="checkbox"/> Document	<input type="checkbox"/> Others (as specified below)
SUBJECT :	Request for Information - Confirmation on Wire Mesh Screen Details at Fan Wall Corridors.			

Total Page (s) : 3 (Including this page)

FUNCTION :	<input type="checkbox"/> Structural (ST)	<input type="checkbox"/> Electrical & Communication (EL)	<input type="checkbox"/> Mechanical (ME)	<input type="checkbox"/> Vertical Transport (VT)
	<input checked="" type="checkbox"/> Architectural (AR)	<input type="checkbox"/> Fire Protection (FI)	<input type="checkbox"/> Hydraulic & Sanitary (HY)	<input type="checkbox"/> Other (O)


(1) CONTRACTOR REQUEST FOR INFORMATION :

GAA Would like to Request confirmation on the Wire mesh screen details at the Fan wall corridors.

1. Since there is no detailed drawing showing wire mesh screen wall between Data Hall and Fan wall Corridor in tender, GAA Would like to propose wire mesh screen walls details by referring the designs installed in Phase 4 BKK1 Level 6. Please refer the attached file for the details.

GAA Would like to inquire if the proposed designs can be acceptable or not.

Requested by : 
Engineering Manager

Reviewed by : 
Project Manager

(2) ATTN : Commtech Asia (Thailand)

☐ For Approval ☐ See Note ☒ Please Clarify

Note : Aurecon to provide clarification.

From : GAA Group

By : Name / Position Mr. Itsarate Trachuengtong/
Project Manager

Date : 19-Jan-26

Reviewed By : Commtech Asia (Thailand) Name / Position Finlay Coady
Sr. Project Manager
Date : 21 January 2026

(3) ATTN : AURECON

☐ For Approval ☐ See Note ☐ Please Clarify

Note : SLA: The wire mesh between data hall and fan wall corridor shall follow detail on AR-3316.

From : Commtech Asia (Thailand)

By :

Name / Position ()

Date :

Reviewed By : Tarkoon Suwansukhum
AURECON

Name / Position (Tarkoon S / Architect)

Date : 30 January 2026

(4) ATTN : STT GDC

- ☒ Clarification only ☐ Not Approved
- ☐ Approved for proceeding work
- ☐ Approved with comments, proceeding work in compliance with comments
- ☐ Approved with comments, not for proceeding work and need to re-submit


Note : Concur with consultant's response

From : AURECON

By :


Name / Position ()

Date :

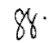
Reviewed By : STT GDC 

Name / Position Sirawit Thepsuwan VP PMO


Date : 5 Feb 2026

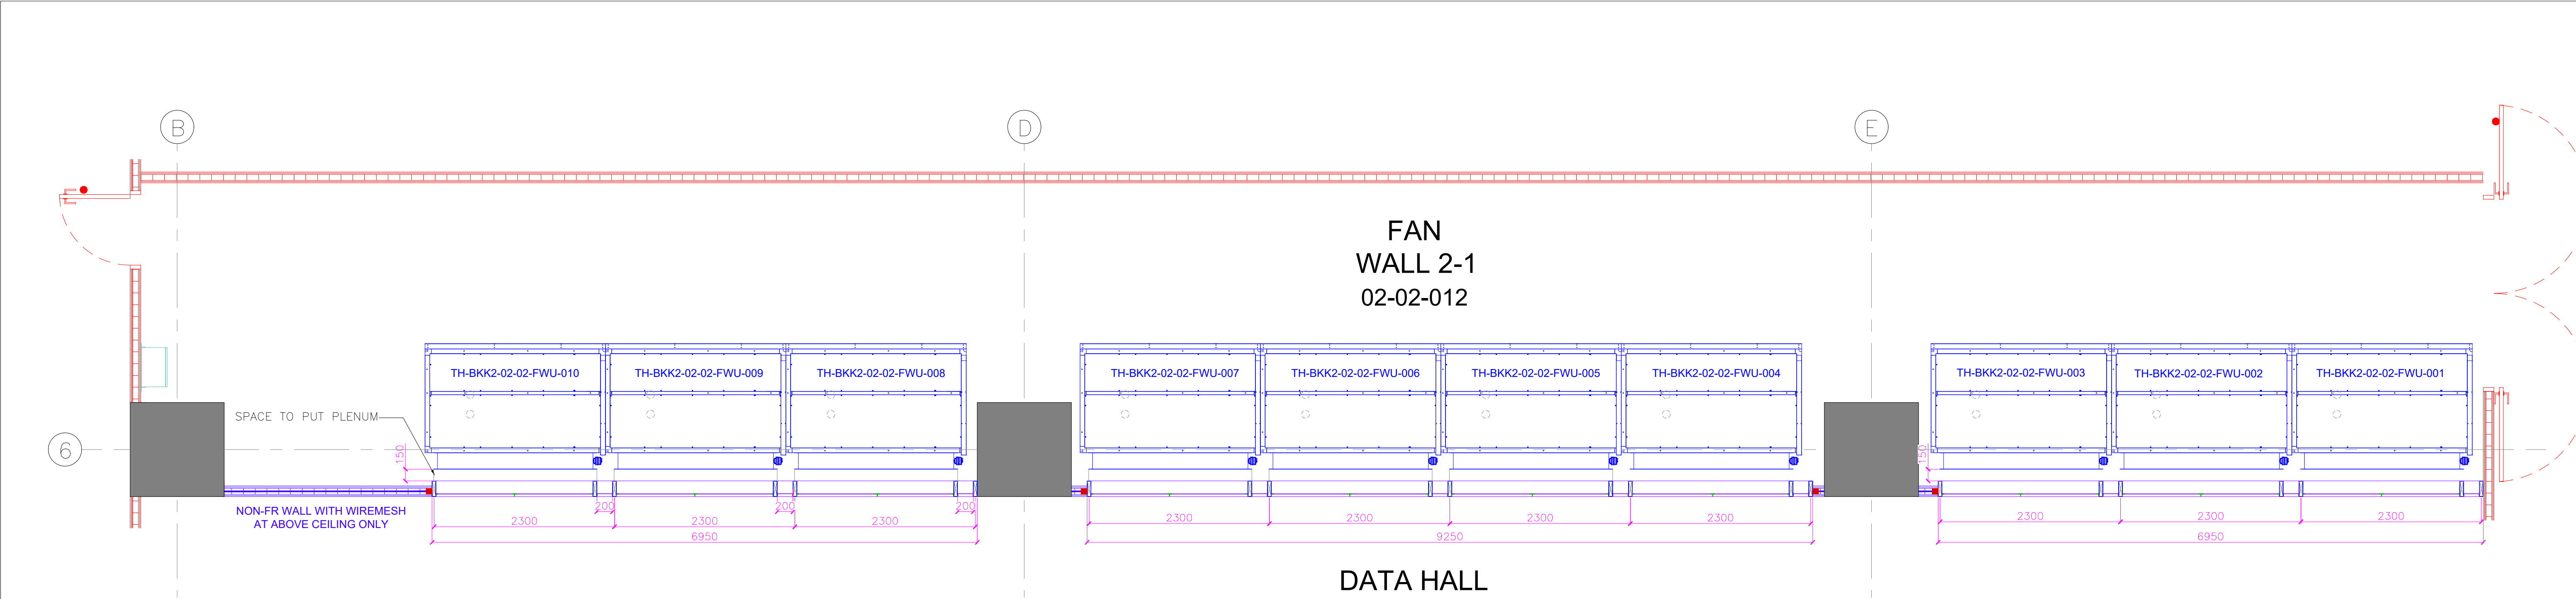


TYPICAL MESHSCREEN LAYOUT
SCALE: 1:40

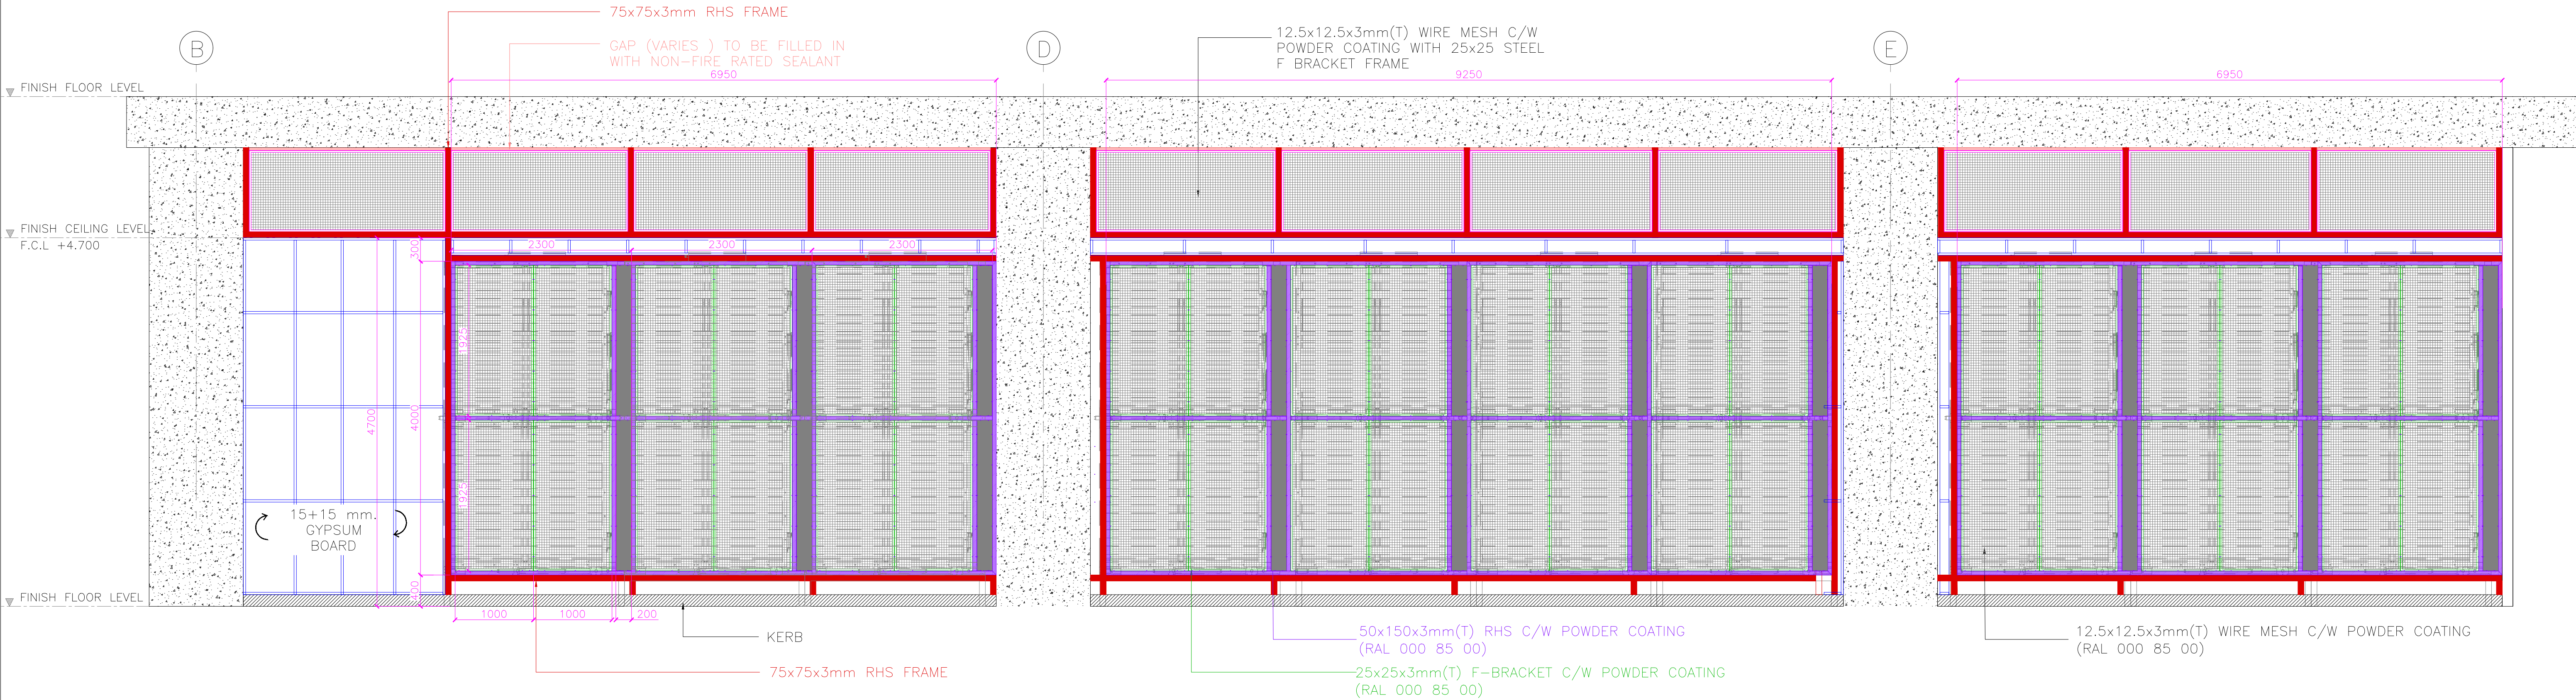


TYPICAL ELEVATION
SCALE: 1:40


REV.	REVISION DESCRIPTION	DATE	ISSUED BY	OWNER :	CONSULTANT :	CONTRACTOR :	PROJECT TITLE :	DRAWN BY :	DATE DRAWN :	SHOP DRAWING NO. :	REV. NO. :
0	SHOP DRAWING FOR APPROVAL	13 JAN 26	TS	<div>STTelemedia Global Data Centres</div> <div>NO. 944 MITRTOWN OFFICE TOWER, 22ND FLOOR, RAMA 4 ROAD, WANGMAI SUBDISTRICT, PATHUMWAN DISTRICT, BANGKOK 10330, THAILAND</div>	<div>cta COMMTECH ASIA</div> <div>999/9 The Office at Central World, 38th Floor, Suite No.3805, Rama 1 Rd., Pathumwan, Bangkok 10330</div>	<div>Gaa Group Company Limited</div> <div>120 Ample Tower Floor 11 Room 8 Bangna-Trad Rd., Bangna Nuea, Bangkok 10250</div>	PROJECT TERRA NORTH (BKK-02)	TS	13 JAN 26	523213-02-SDW-AR-0000	0
								CH	13 JAN 26	-	-
								IT	AS SHOWN : A1	RFAS NO. : 523213-02-RFAS-AR-0000	0
								TYPICAL FAN WALL CORRIDOR WIREMESH LAYOUT & DETAILS			

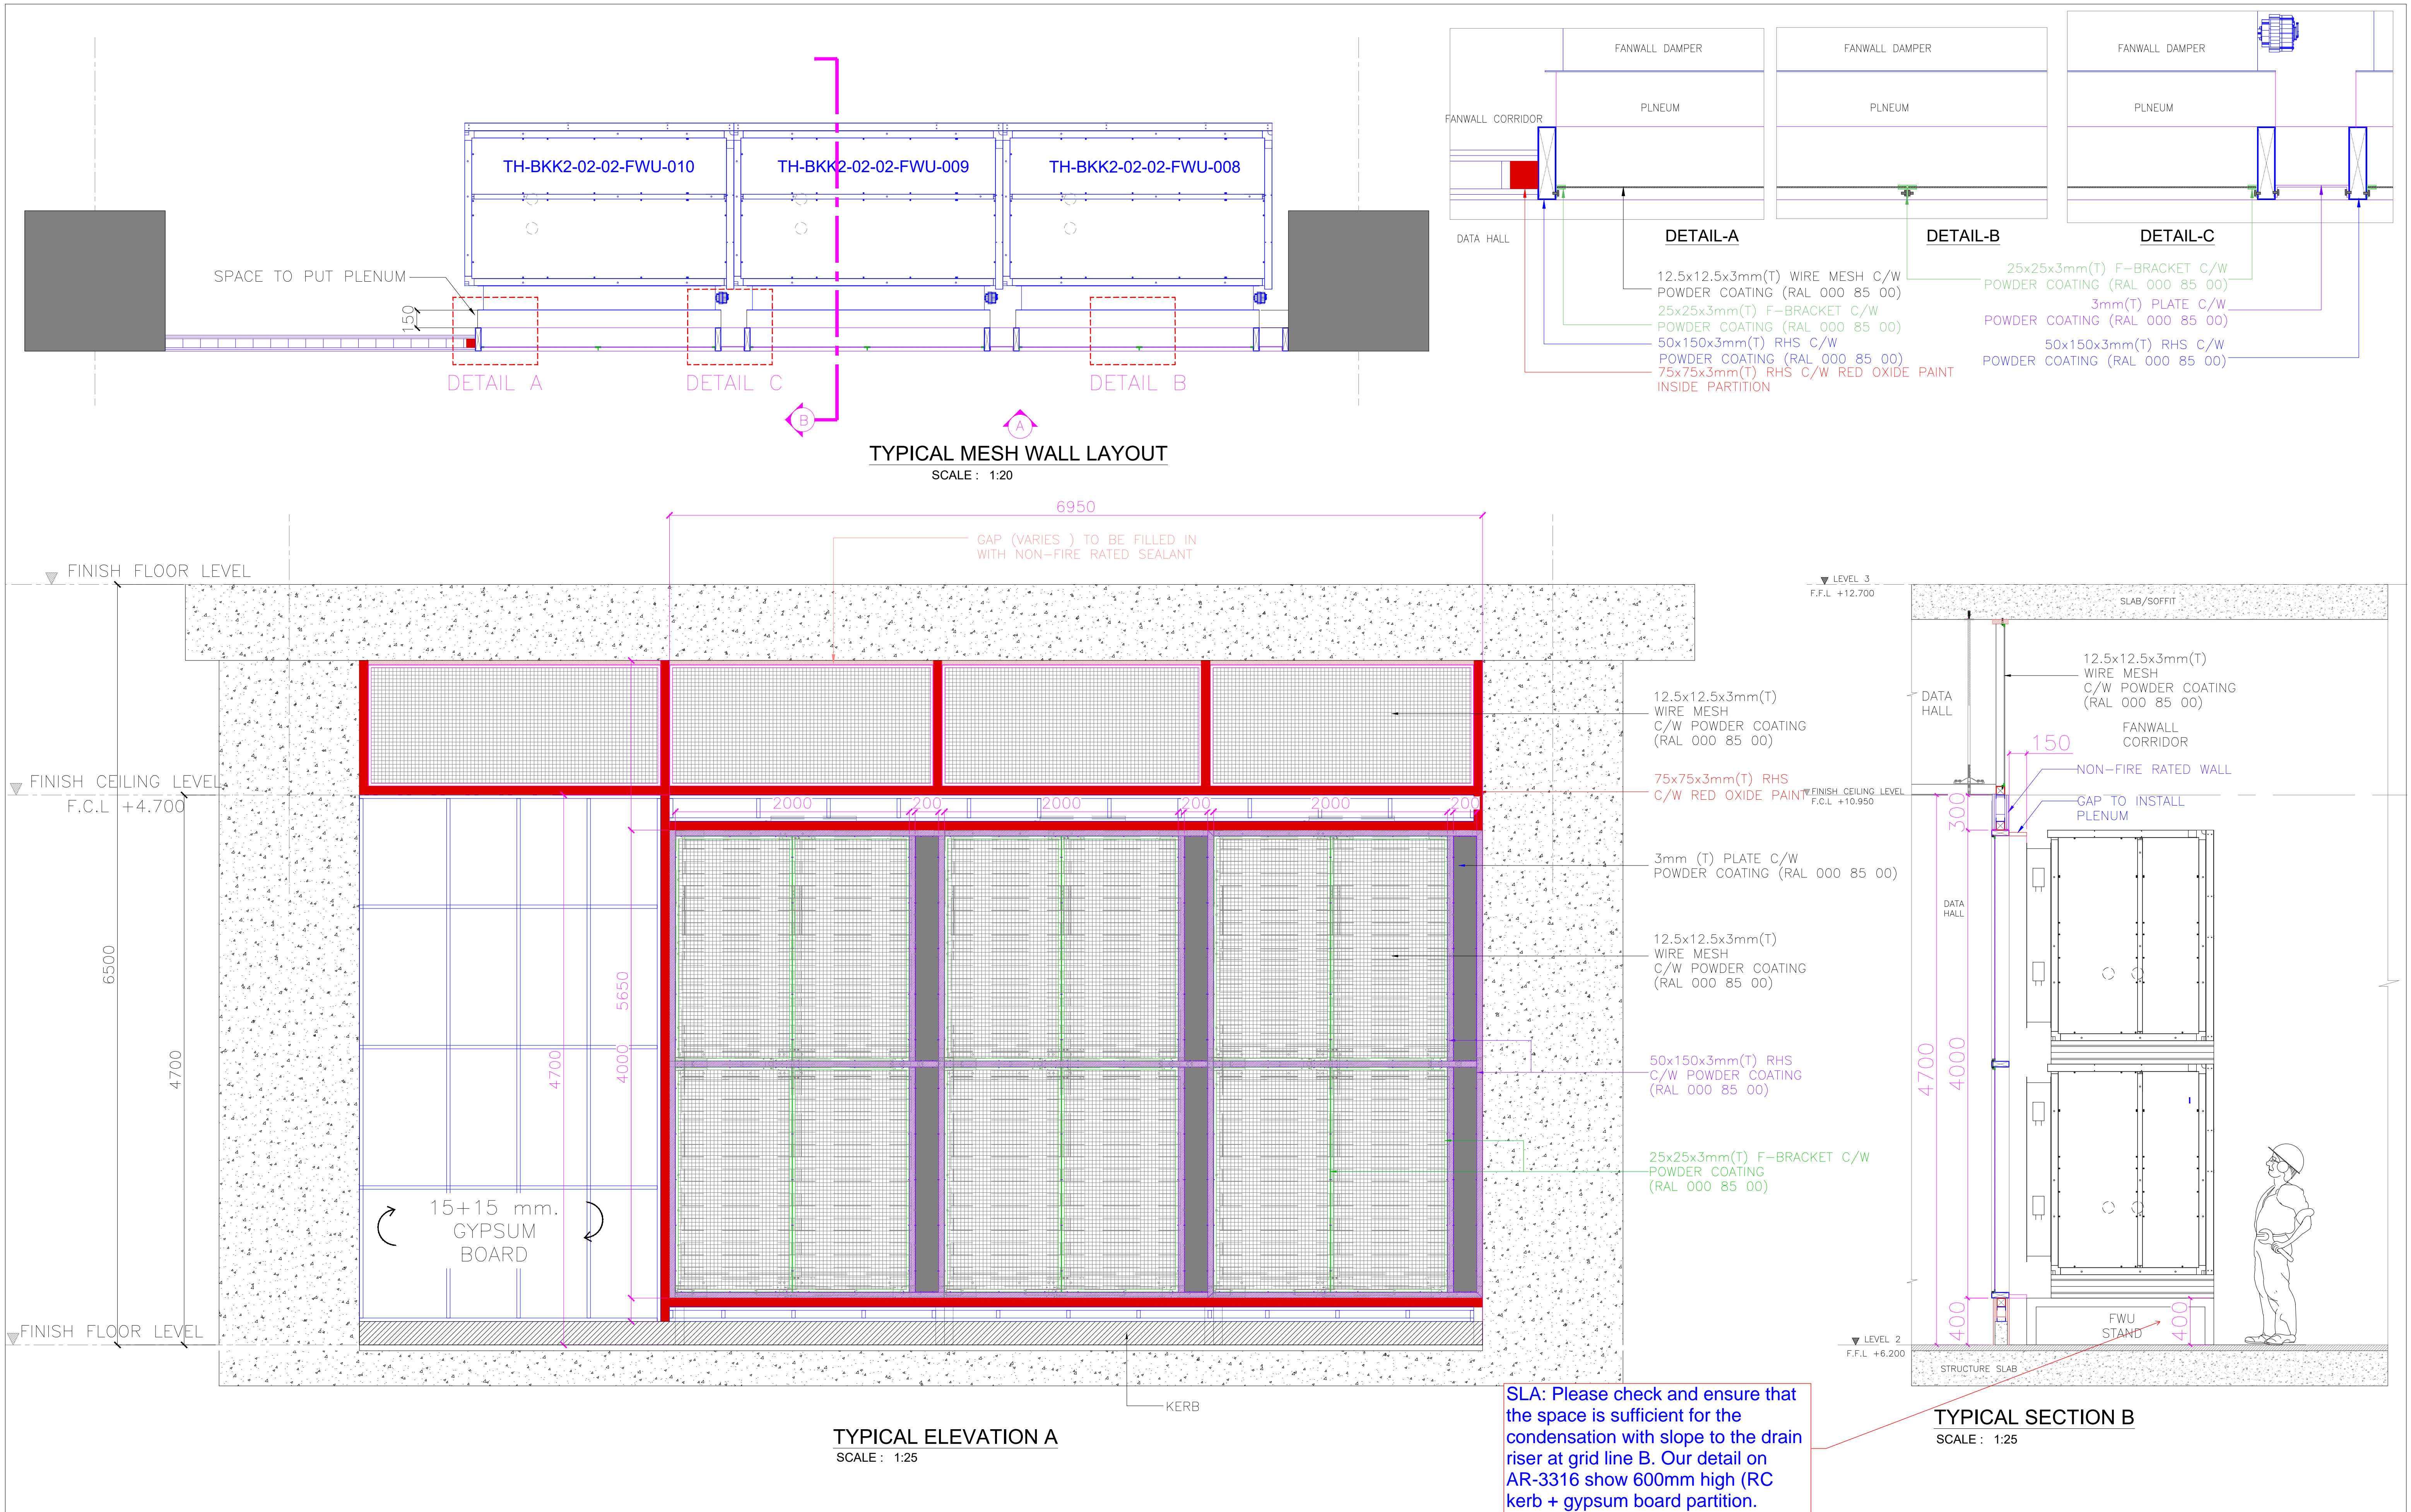


REV.	REVISION DESCRIPTION	DATE	ISSUED BY	OWNER :	CONSULTANT :	CONTRACTOR :	PROJECT TITLE :	DRAWN BY :	DATE DRAWN :	SHOP DRAWING NO. :	REV. NO. :
0	SHOP DRAWING FOR APPROVAL	13 JAN 26	TS	<div><div></div><div>STTelemedia Global Data Centres</div><div>NO. 944 MITRTOWN OFFICE TOWER, 22ND FLOOR, RAMA 4 ROAD, WANGMAI SUBDISTRICT, PATHUMWAN DISTRICT, BANGKOK 10330, THAILAND</div></div>	<div><div>cta</div><div>COMMTECH ASIA</div><div>999/9 The Office at Central World, 38th Floor, Suite No.3805, Rama 1 Rd., Pathumwan, Bangkok 10330</div></div>	<div><div></div><div>Gaa</div><div>Group Company Limited</div><div>120 Ample Tower Floor 11 Room 8 Bangna-Trad Rd., Bangna Nuea, Bangkok 10250</div></div>	PROJECT TERRA NORTH (BKK-02)	TS	13 JAN 26	523213-02-SDW-AR-0000	0
								CHECKED BY :	DATE ISSUE :	REFERENCE DRAWING NO. :	REV. NO. :
								CH	13 JAN 26	-	-
								APPROVE BY :	SCALE :	RFAS NO. :	REV. NO. :
							TYPICAL FAN WALL CORRIDOR WIREMESH LAYOUT & DETAILS	IT	AS SHOWN : A1	523213-02-RFAS-AR-0000	0

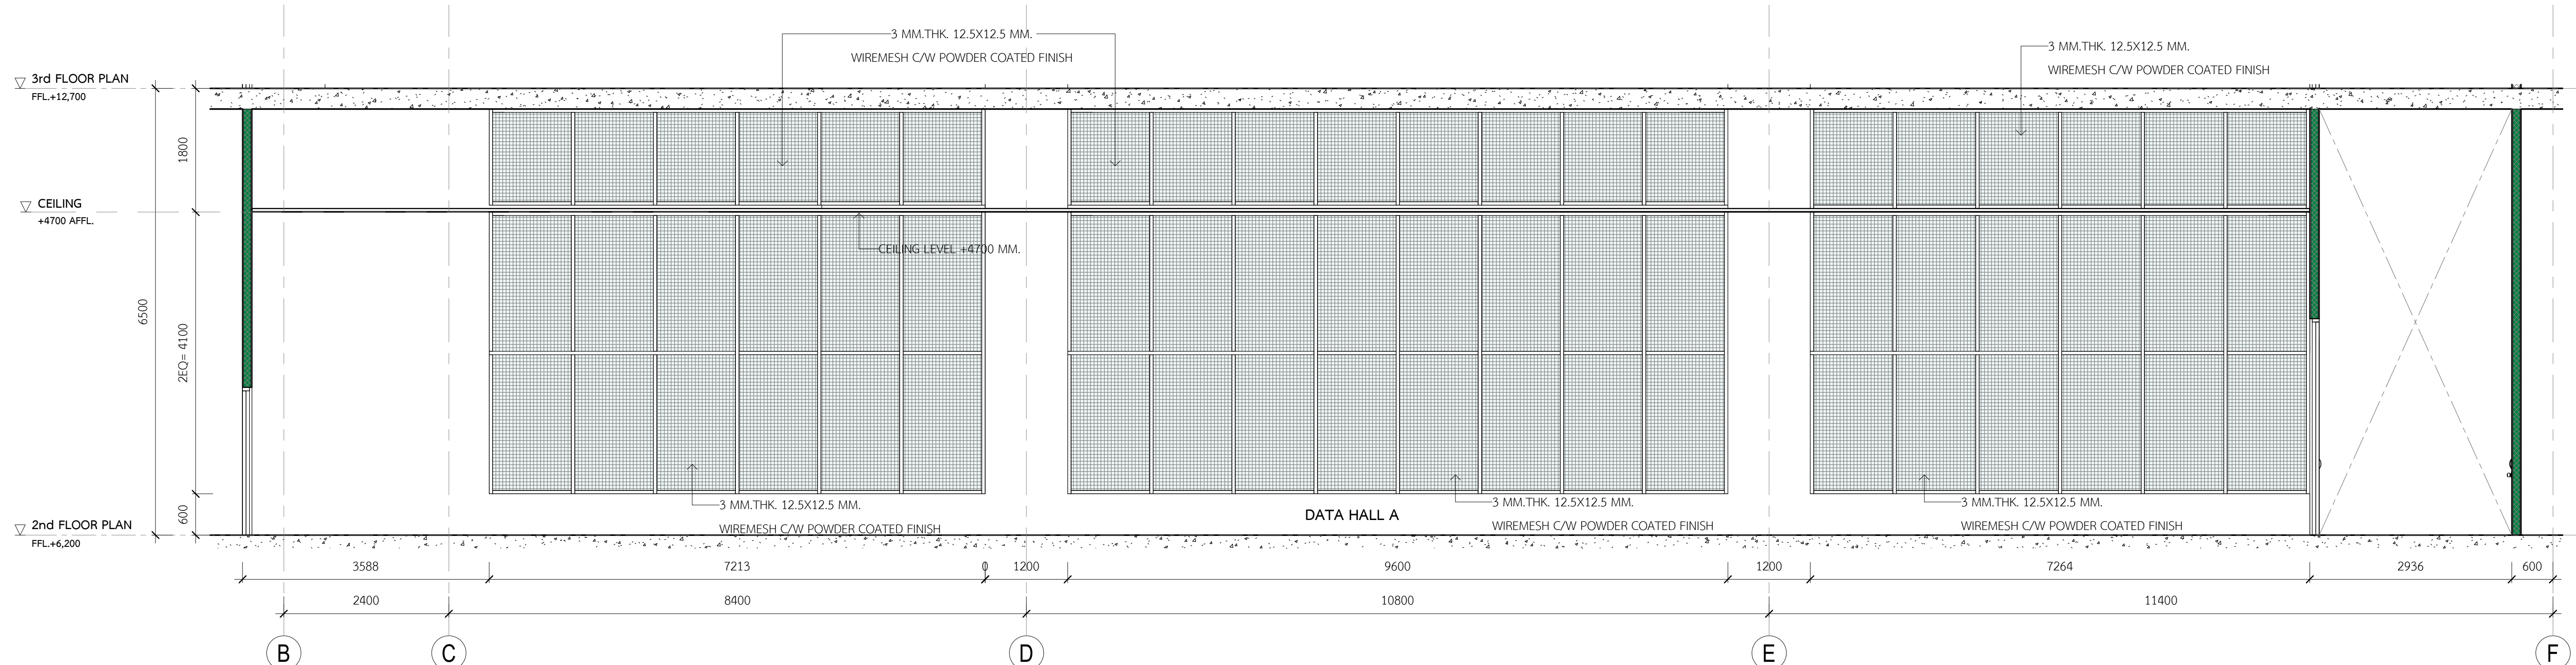


2nd ELEVATION 11
SCALE 1 : 50

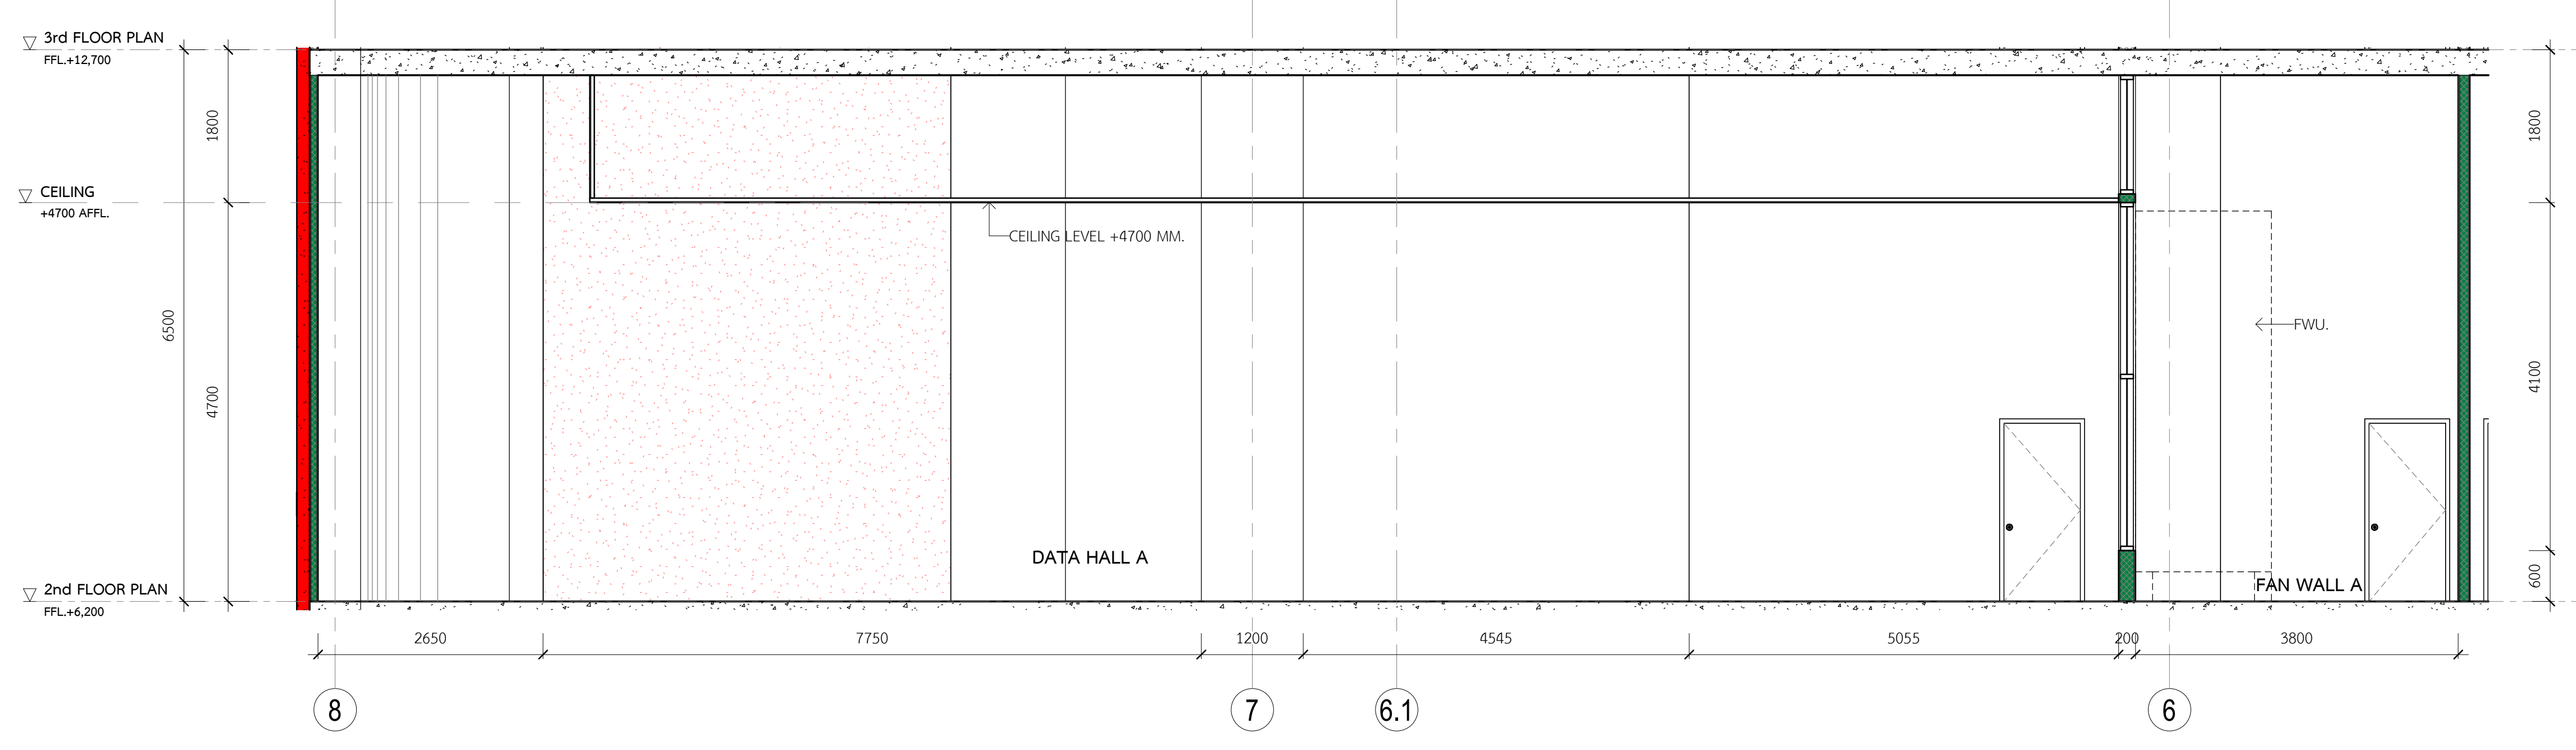

2nd ELEVATION 12
SCALE 1 : 50

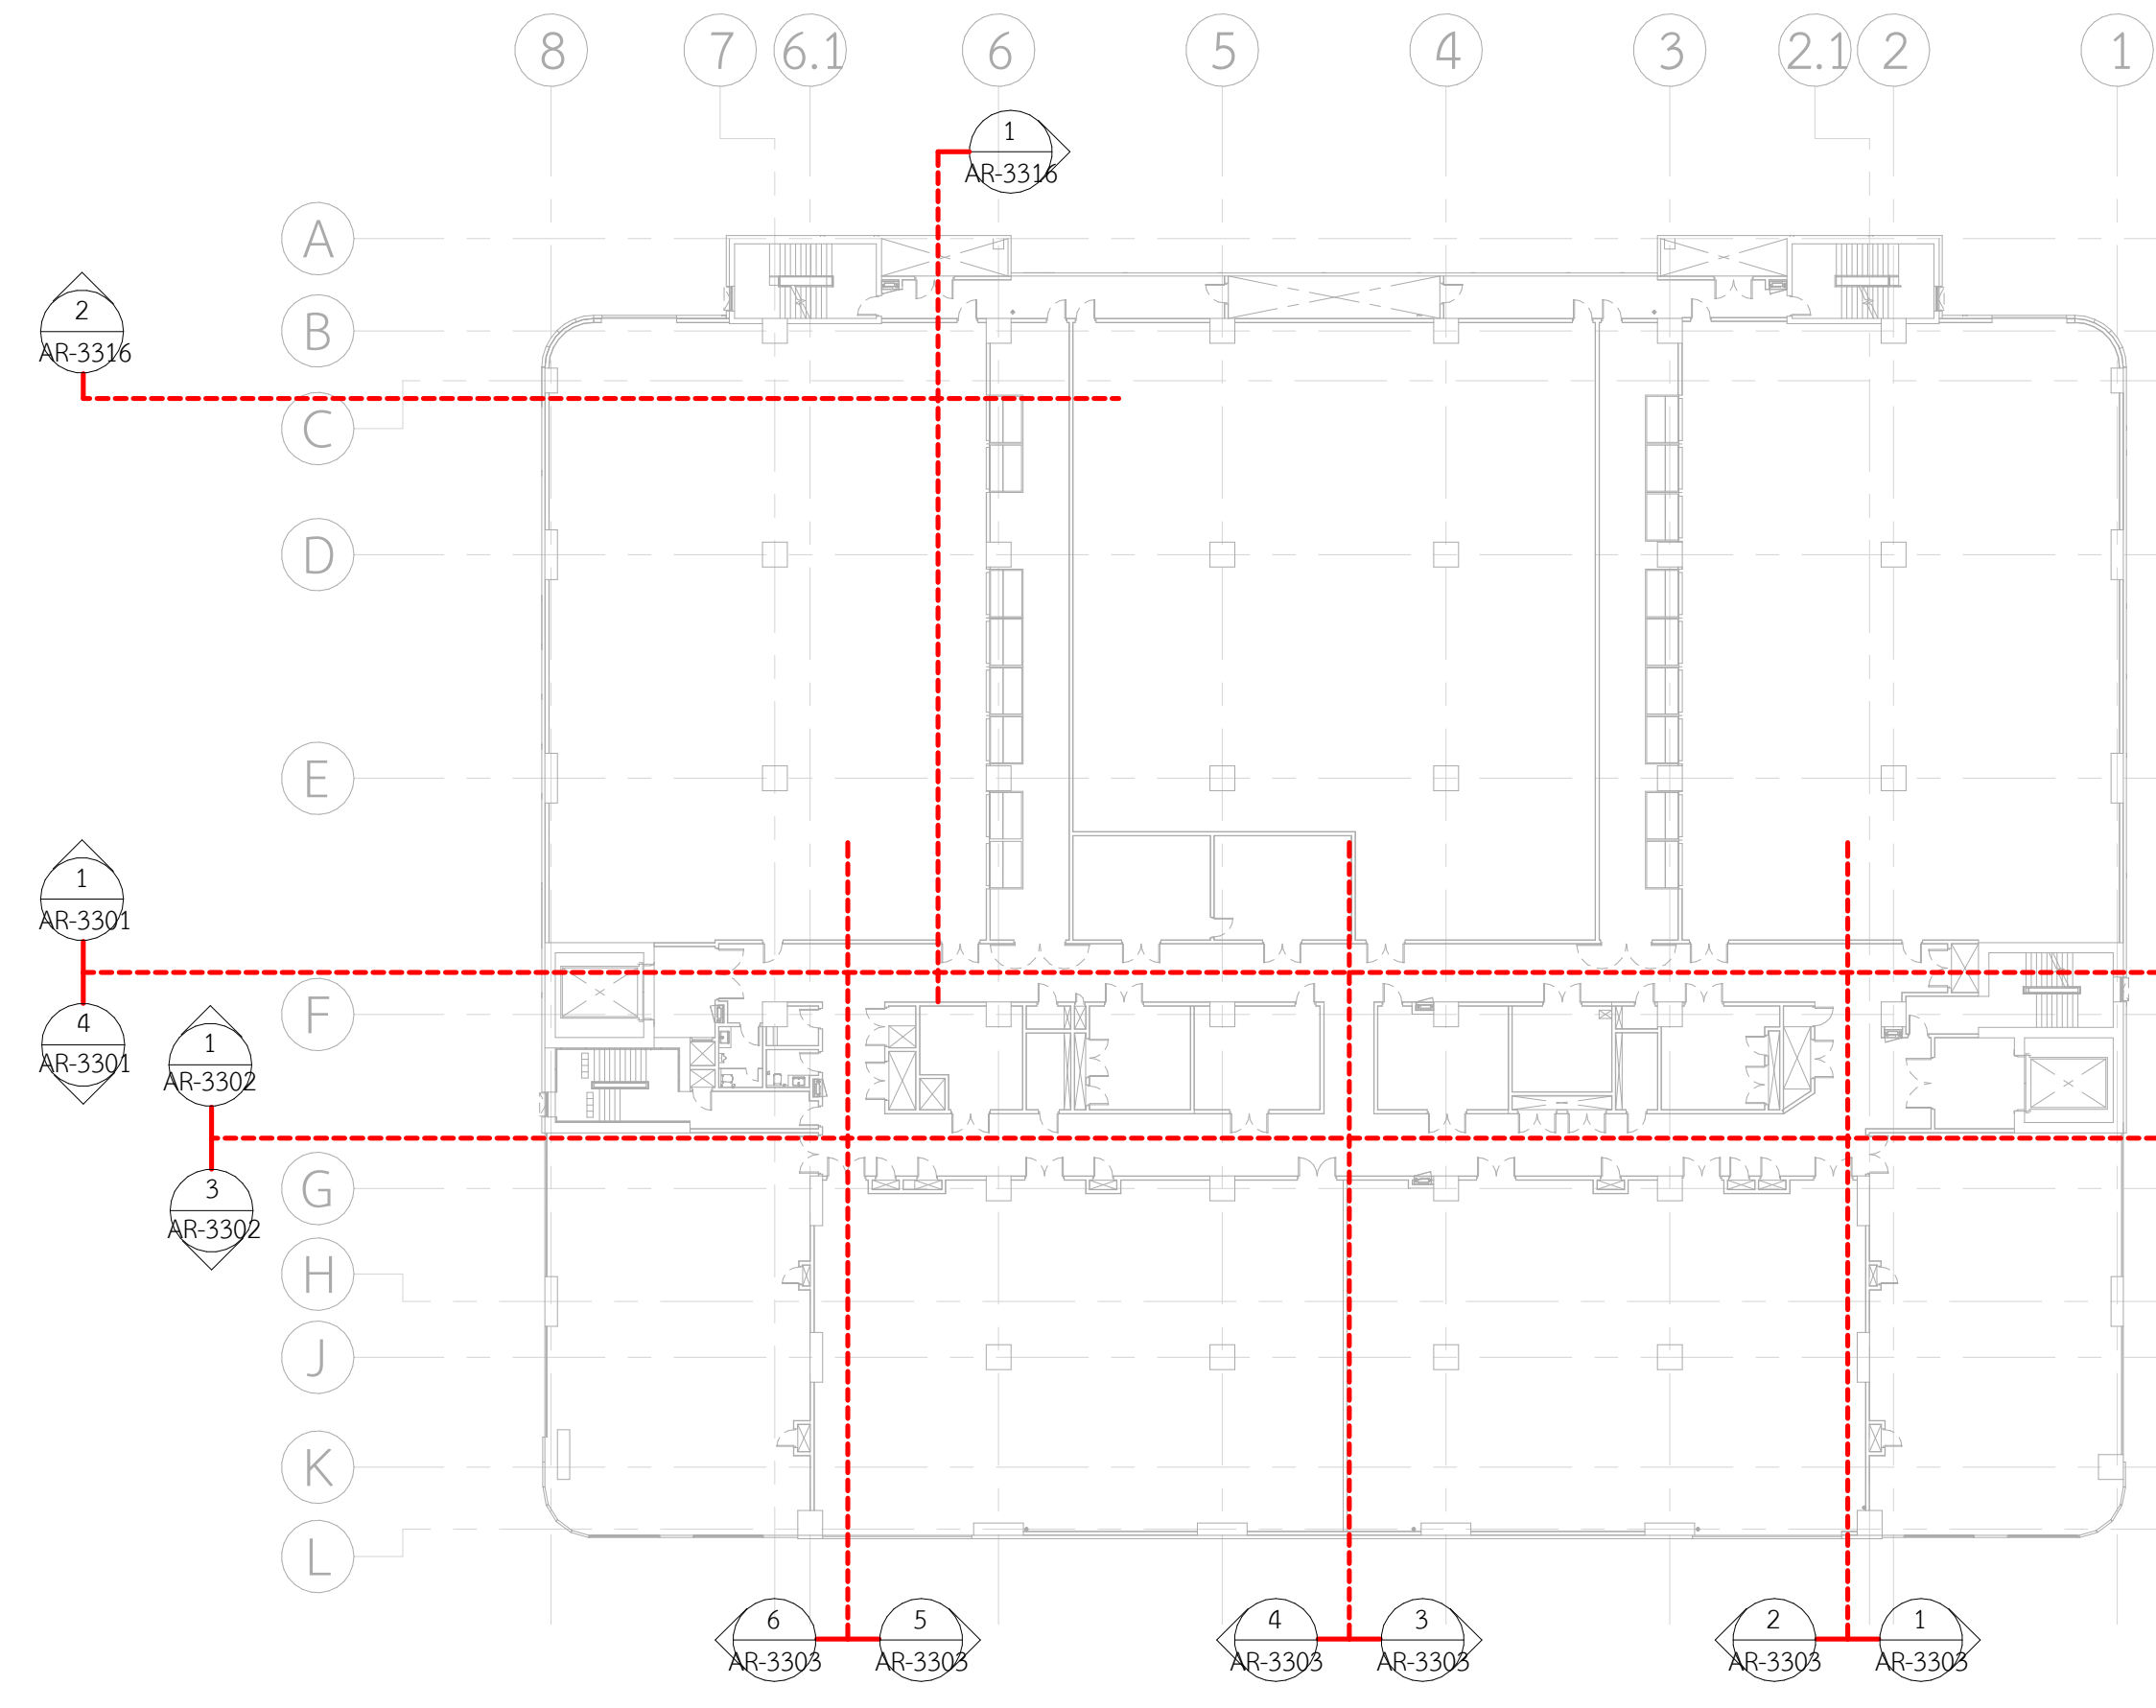

KEY PLAN FLOOR 2nd CORRIDOR ELEVATION
SCALE 1 : 350

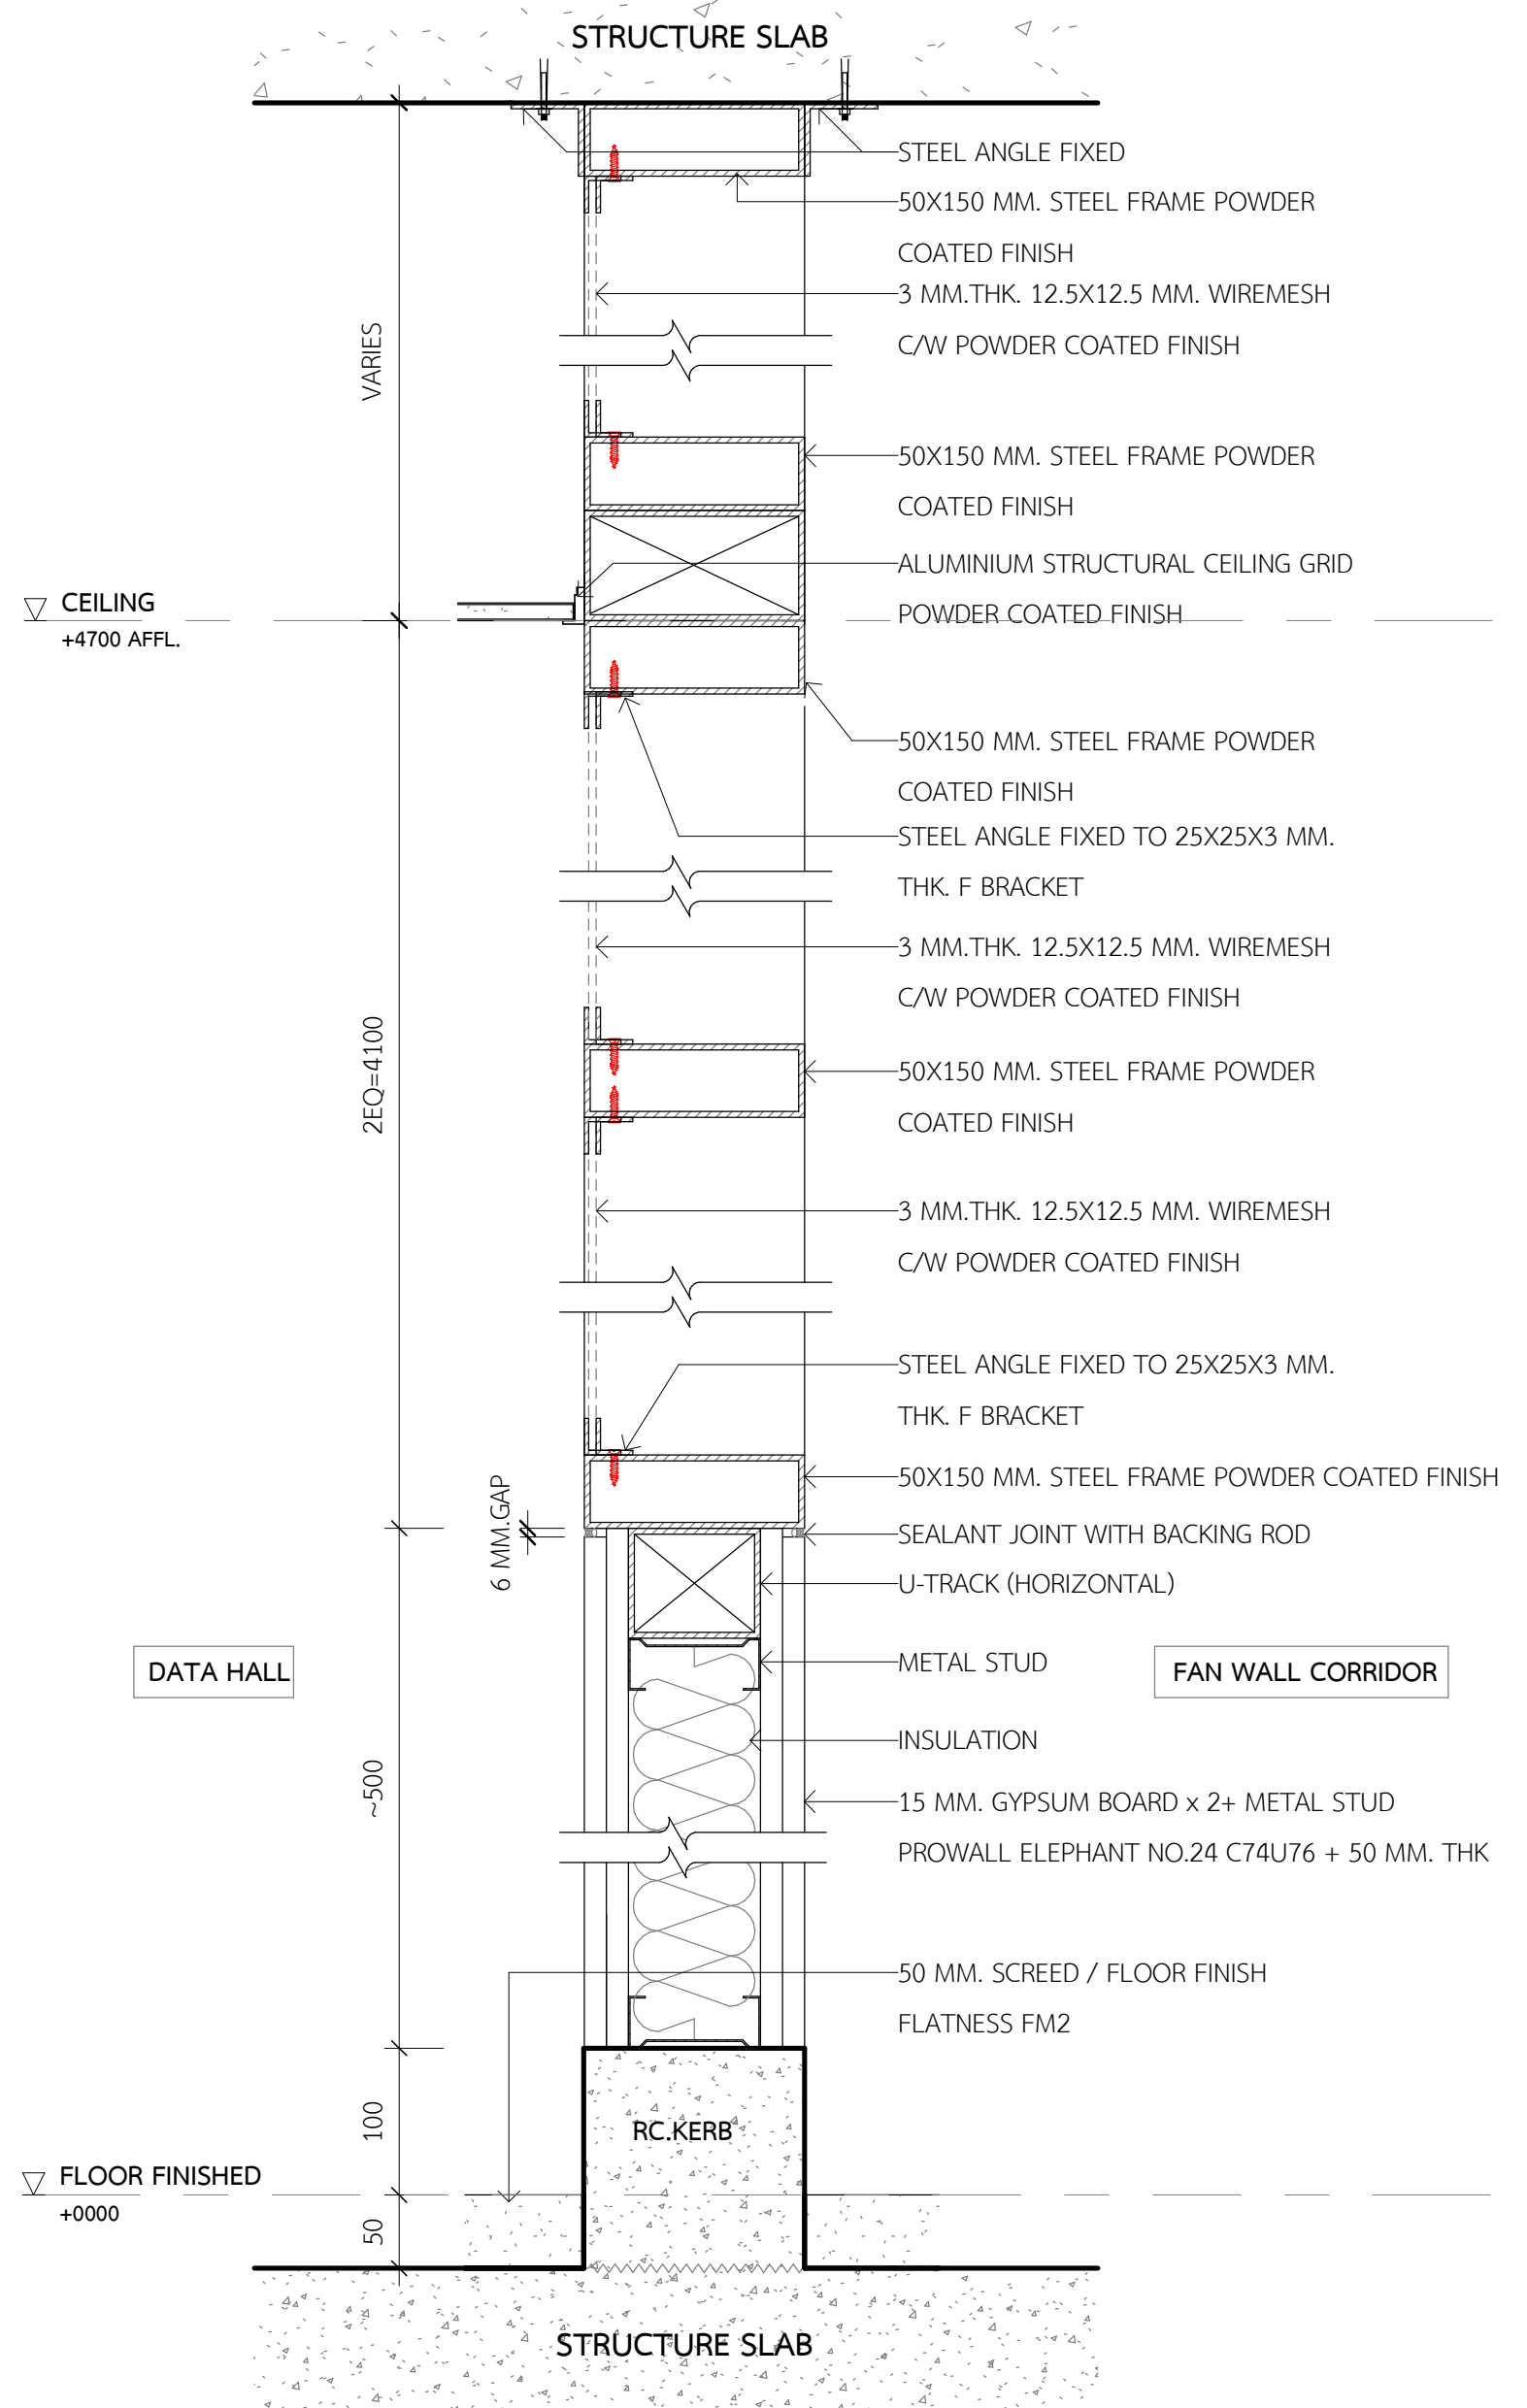

TYPICAL SECTION AT FAN WALL UNIT
SCALE 1 : 5

CLIENT
STTelemedia
Global Data Centres
STT GDC (THAILAND) CO., LTD.
944 Mitotown Office Tower, 22nd-23rd Floor
Rama 4 Road, Wangmai, Pathumwan, Bangkok 10330

ENGINEER
aurecon
www.aurecongroup.com
AURECON CONSULTING (THAILAND) CO., LTD.
89 AA Capital Center Building, 21st Floor, Unit 2104-2107
Ratchadapisek Road, Din Daeng, Bangkok 10400

STRUCTURAL REVIEWER	
สถาปนิก	สถาปนิก
ชื่อ	ชื่อ
ชื่อ	ชื่อ
ชื่อ	ชื่อ
ชื่อ	ชื่อ

ANITARY AND FIRE PROTECTION	
ชื่อ	ชื่อ
ชื่อ	ชื่อ
ELECTRICAL AND COMMUNICATIONS	
ชื่อ	ชื่อ
ชื่อ	ชื่อ
MECHANICAL ENGINEER	
ชื่อ	ชื่อ
ชื่อ	ชื่อ
ARCHITECTS
StevenLeach
Partners in creative solutions
STEVEN J. LEACH ARCHITECTS LIMITED
17/10/25
62 อาคารเฉลิมพระเกียรติฯ 10 ซอยรัชดาภิเษก ถนนรัชดาภิเษก กรุงเทพฯ 10330

ARCHITECT	
ชื่อ	ชื่อ
ชื่อ	ชื่อ

REVISION	
REV	DATE
DATE	DESCRIPTION
APP	DATE

SCALE	
SCALE	SIZE
As indicated	A0
DRAWN	APPROVED
CC	DATE
DESIGNED	DATE
SLA	DATE
CHECKED	DATE
TS	DATE

PROJECT
อาคารศูนย์ข้อมูลแห่งชาติ
8 ชั้น จำนวน 1 หลัง
อาคารศูนย์ข้อมูล 28 ชั้น อาคารสำนักงาน อาคารจอดรถ อาคาร
อาคารศูนย์ข้อมูล 10240

TITLE
INTERIOR ELEVATION
2nd FLOOR LEVEL

DRAWING NUMBER
523213 - 02 - DRG - AR-3316