

**REQUEST FOR INFORMATION (RFI)**

PROJECT :	BKK2	R.F.I. NO. :	523213-01-RFI-AR-0041
TO :	CTA	ATTENTION :	CTA
SUBMITTED DATE:	6-Feb-26	NEED REPLY BY DATE :	13-Feb-26

SUBMISSION OF :  Q&A  Drawing  Document  Others (as specified below)

SUBJECT : Request for Information - Confirm External Paint Color and Technical Specification for Generators Room

Total Page (s) : 2 (Including this page)

FUNCTION :	<input type="checkbox"/> Structural (ST)	<input type="checkbox"/> Electrical & Communication (EL)	<input type="checkbox"/> Mechanical (ME)	<input type="checkbox"/> Vertical Transport (VT)
	<input checked="" type="checkbox"/> Architectural (AR)	<input type="checkbox"/> Fire Protection (F1)	<input type="checkbox"/> Hydraulic & Sanitary (HY)	<input type="checkbox"/> Other (O)

**(1) CONTRACTOR REQUEST FOR INFORMATION :**



Please provide confirmation on the external paint color and technical specifications for the generator rooms.


Requested by :   
Engineering Manager

Reviewed by :   
Project Manager

(2) ATTN : Commtech Asia (Thailand)			From : GAA Group		
<input type="checkbox"/>	For Approval	<input type="checkbox"/>	See Note	<input checked="" type="checkbox"/> Please Clarify	By :  Mr. Itsarate Trachuengtong/ Project Manager
					Date : 6-Feb-26
Note :	Please Aurecon to provide confirmation on the external paint color and technical specifications for the generator rooms clarification.				
					Reviewed By : Commtech Asia (Thailand)
					Name / Position : Aphisakda Phueakchanhuek Construction Engineer
					Date : 2/9/2026

(3) ATTN : AURECON			From : Commtech Asia (Thailand)			
<input type="checkbox"/>	For Approval	<input type="checkbox"/>	See Note	<input type="checkbox"/>	Please Clarify	By :  Tarkoon Suwansukhum/AURECON
					Name / Position : ( Tarkoon S / Architect )	
					Date : 10 February 2026	
Note :	SLA: Please refer to the notes in the attached markup.					
					Reviewed By : Tarkoon Suwansukhum/AURECON	
					Name / Position : ( Tarkoon S / Architect )	
					Date : 10 February 2026	

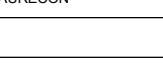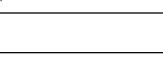(4) ATTN : STT GDC			From : AURECON		
<input type="checkbox"/>	Clarification only	<input type="checkbox"/>	Not Approved	By : 	
<input type="checkbox"/>	Approved for proceeding work	<input type="checkbox"/>		Name / Position : ( )	
<input type="checkbox"/>	Approved with comments, proceeding work in compliance with comments	<input type="checkbox"/>		Date : 	
<input type="checkbox"/>	Approved with comments, not for proceeding work and need to re-submit	<input type="checkbox"/>			
Note :	Reviewed By : STT GDC				
					Name / Position : 
					Date : 

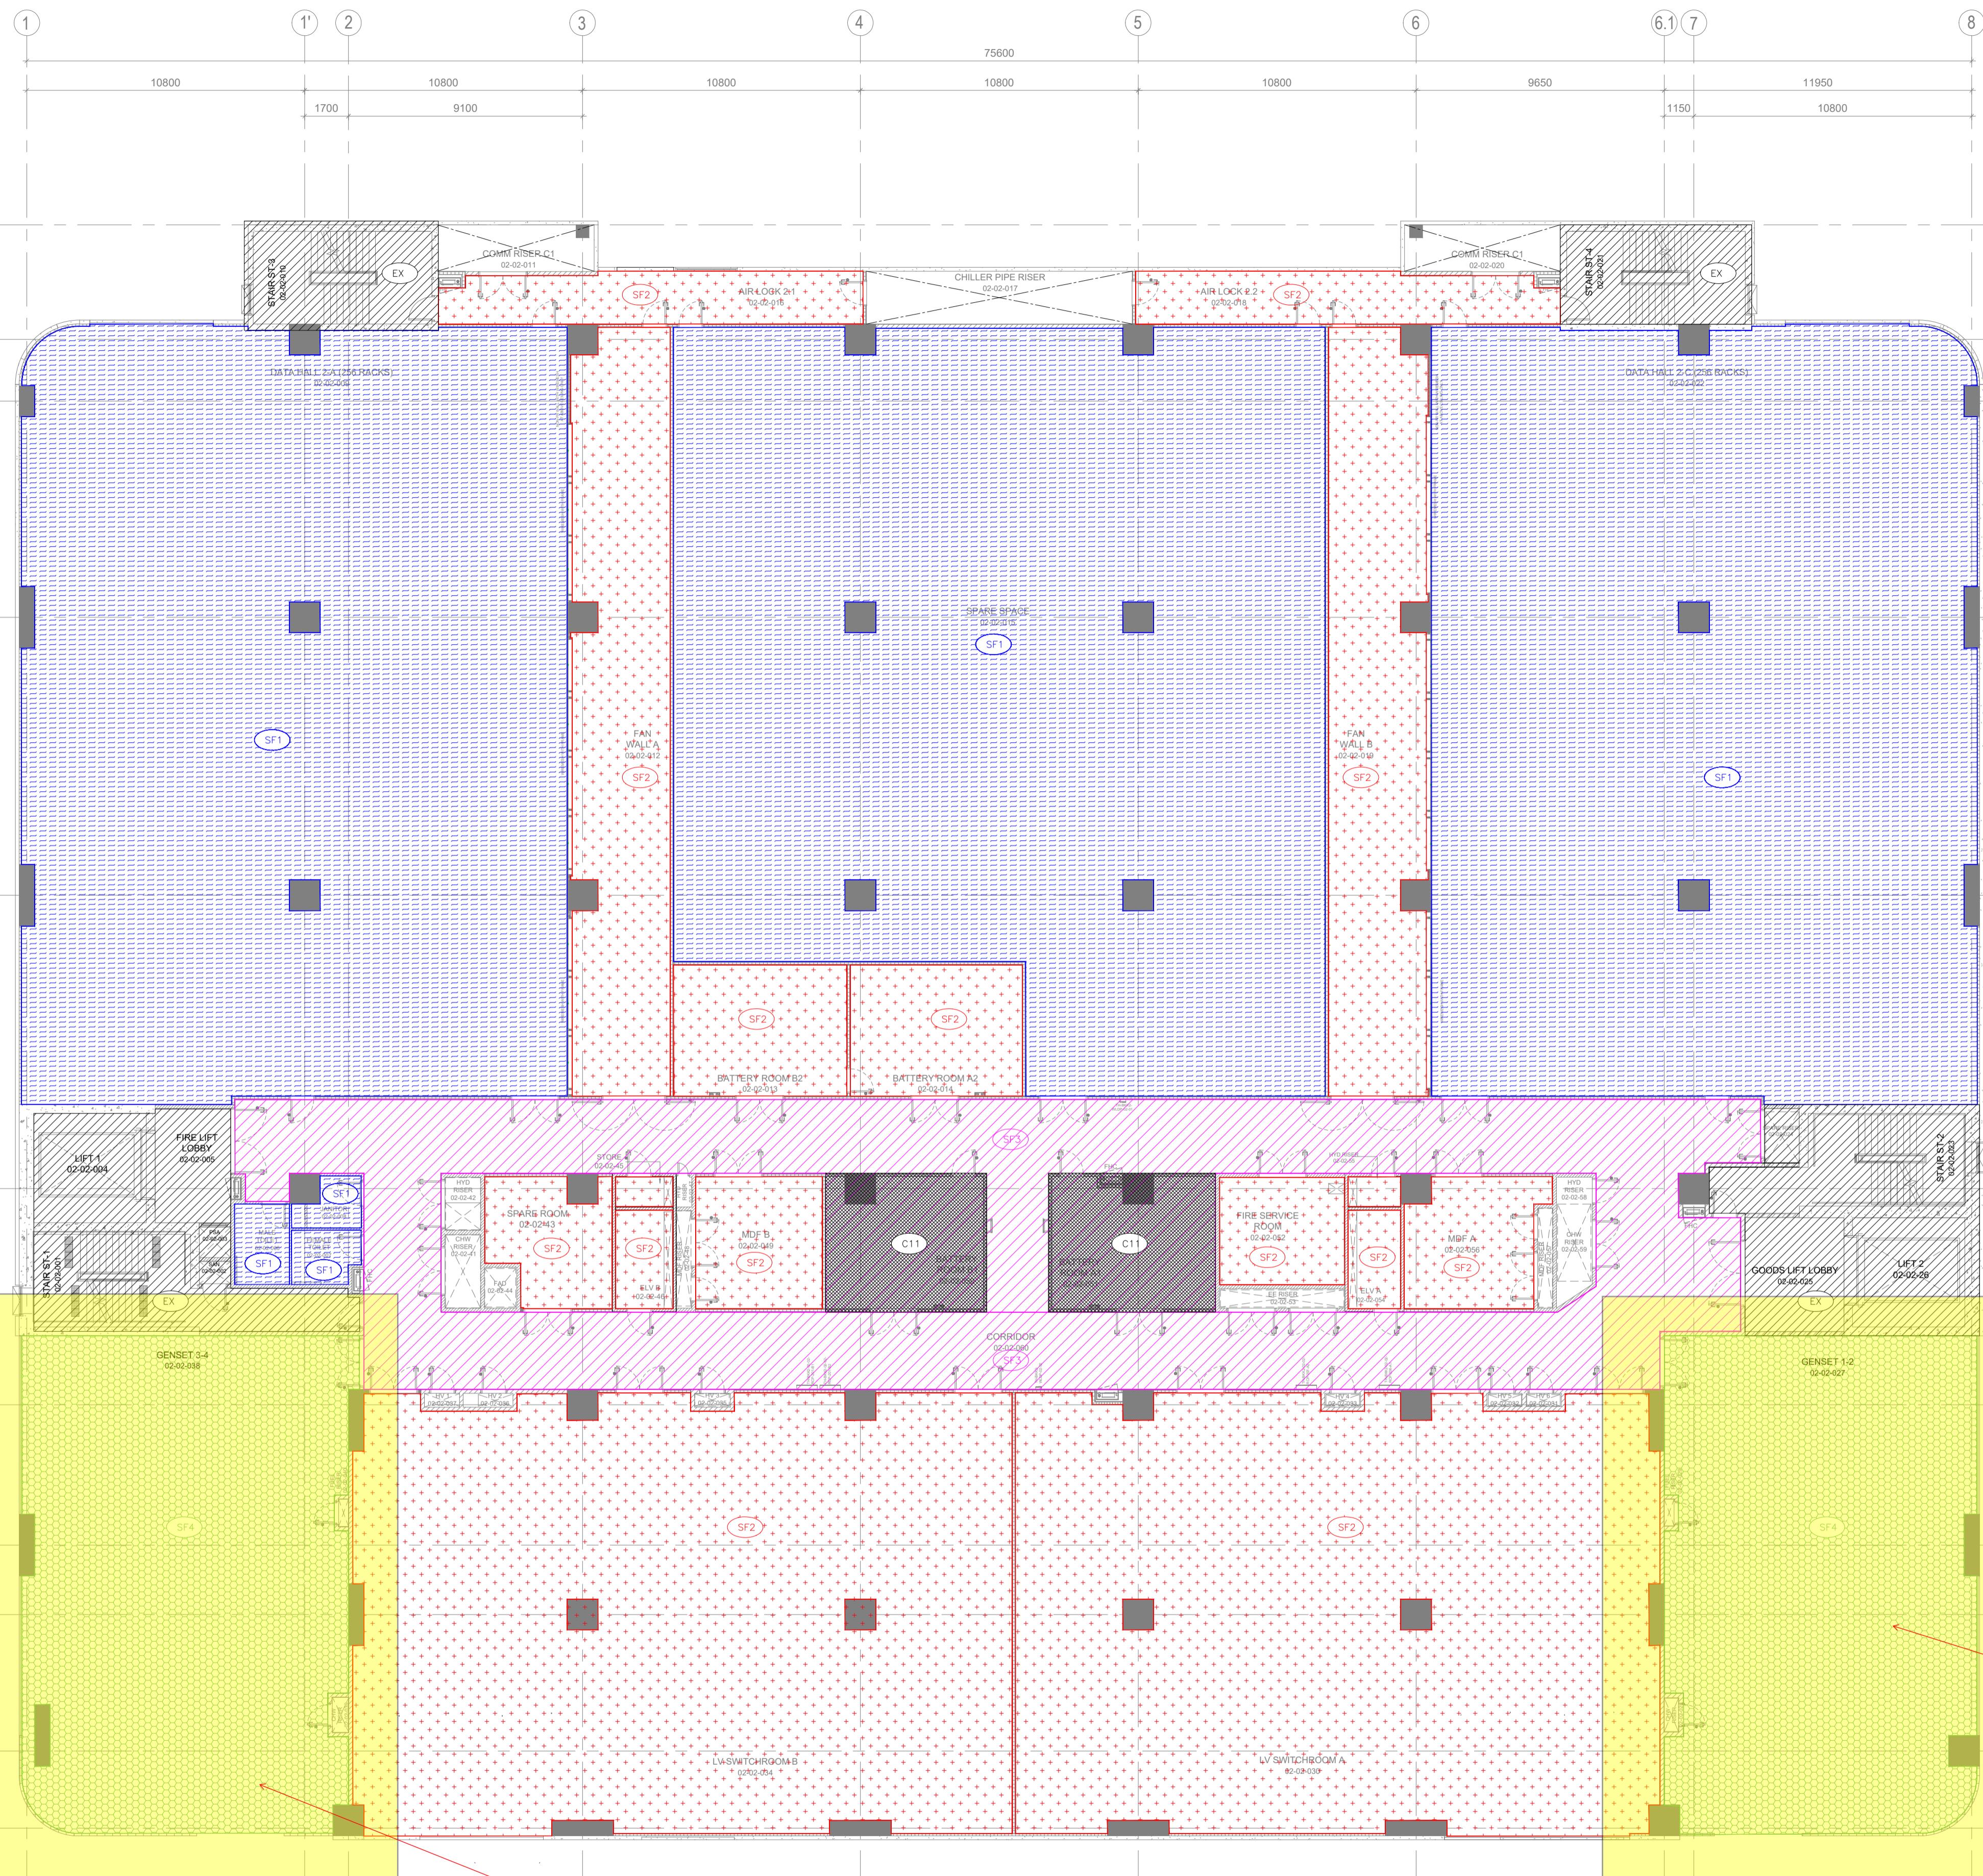


#### SOFFIT FINISHES SCHEDULE

SOFFIT NO.	HATCH PATTERN	LOCATION	DESCRIPTION	SPECIFICATION
SF1		DATA HALL, TOILET	COLOR PAINT	SUPERSHIELD DURACLEAN MATT SHADE (M101) PEARL WHITE
SF2		AS INDICATED	COLOR PAINT	EMULSION PAINT (RAL 7012) BASALT GREY
SF3		CORRIDOR	COLOR PAINT	EMULSION PAINT (RAL 7047) TELEGREY
SF4		GENERATOR ROOM	PAINT	EXPOSED CEILING WITH EXTERNAL PAINT
EX		AS INDICATED	EXISTING	EXISTING

#### NOTE:

- EXTERNAL PAINT COLOUR AND SPECIFICATION FOR GENERATOR ROOMS NEED TO CONFIRM.

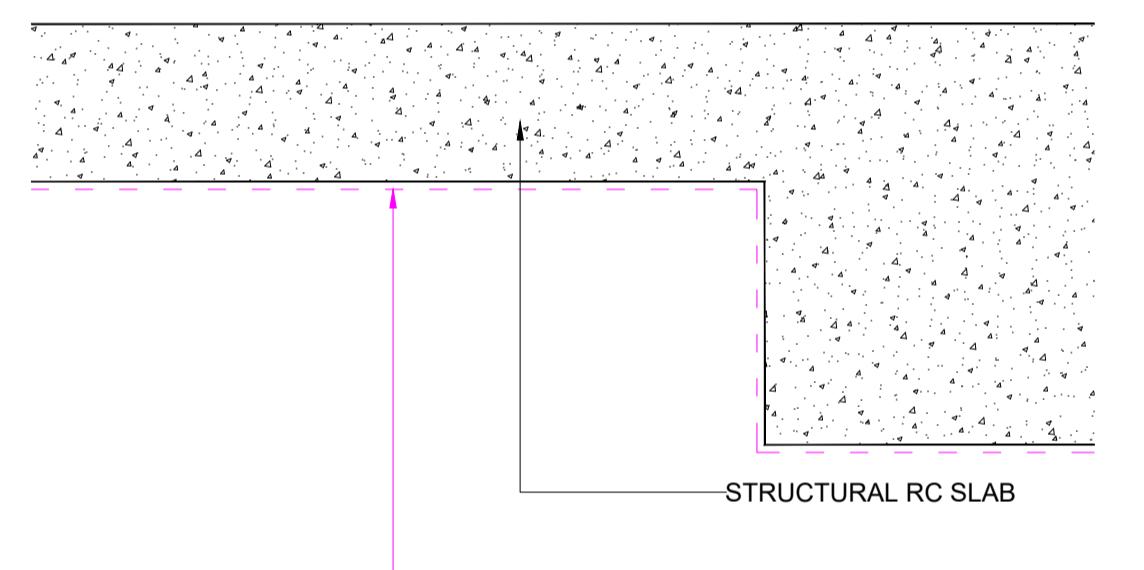

#### TYPICAL DETAIL

SLA: The genset ceiling shall be paint Dark grey RAL 7012

#### LAYOUT

REV.	REVISION DESCRIPTION	DATE	ISSUED BY	OWNER :	CONSULTANT :	CONTRACTOR :	PROJECT TITLE :	DRAWN BY :	DATE DRAWN :	SHOP DRAWING NO. :	REV. NO. :
0	SHOP DRAWING FOR APPROVAL	23 JAN 26	TS	ST Telemedia Global Data Centres	cta COMMTECH ASIA	Gaa Group Company Limited	PROJECT TERRA NORTH (BKK-02)	TS	23 JAN 26	523213-01-SDW-AR-5200	0
							DRAWING TITLE :	CHECKED BY :	DATE ISSUE :	REFERENCE DRAWING NO. :	REV. NO. :
								CH	23 JAN 26	523213-02-DRG-AR-6002	0
							APPROVE BY :	IT	SCALE :	RFAS NO. :	REV. NO. :
									1:150 - A1	523213-01-RFAS-AR-0049	0