

REQUEST FOR INFORMATION (RFI)

PROJECT :	BKK2	R.F.I. NO. :	523213-01-RFI-AR-0042
TO :	CTA	ATTENTION :	CTA
SUBMITTED DATE:	6-Feb-26	NEED REPLY BY DATE :	13-Feb-26

SUBMISSION OF : ☒ Q&A ☒ Drawing ☐ Document ☐ Others (as specified below)

SUBJECT : Request for Information - Clarify Ceiling Types for Level 5 Battery Room B1,B2,C1,C2,D1 & D2 Areas.

Total Page (s) : 3 (Including this page)

FUNCTION :	<input type="checkbox"/> Structural (ST)	<input type="checkbox"/> Electrical & Communication (EL)	<input type="checkbox"/> Mechanical (ME)	<input type="checkbox"/> Vertical Transport (VT)
	<input checked="" type="checkbox"/> Architectural (AR)	<input type="checkbox"/> Fire Protection (FI)	<input type="checkbox"/> Hydraulic & Sanitary (HY)	<input type="checkbox"/> Other (O)

(1) CONTRACTOR REQUEST FOR INFORMATION :

GAA would like to clarify ceiling types for level 5 Battery Room B1,B2,C1,C2,D1 & D2 areas.

1. According to IFC drawing 523213-02-DRG-AR-2605, the ceiling type of Battery Rooms B1, B2, C1, C2, D1 & D2 was shown as C11.

There is Raised floor which is 600mm height from F.F.L.

Ceiling Types C11 aims for the paint under metal slab and there is no double slab at high level of those battery rooms mentioned above as per designed drawings,

GC would like to clarify which ceiling types to be used for the mentioned battery rooms.

Requested by : 

Engineering Manager

Reviewed by : 

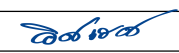
Project Manager

(2) ATTN : Commtech Asia (Thailand)

☐ For Approval ☐ See Note ☒ Please Clarify

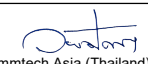
Note : Please Aurecon to provide clarification.

From : GAA Group

By : 

Name / Position : Mr. Itsarate Trachuengtong/  
Project Manager

Date : 6-Feb-26

Reviewed By :   
Commtech Asia (Thailand)

Name / Position : Aphisakda Phueakchanthuek  
Construction Engineer

Date : 2/9/2026

(3) ATTN : AURECON

☐ For Approval ☐ See Note ☐ Please Clarify

Note : SLA: Battery room B1, B2, C1, C2, D1, D2 ceiling finish shall be C4.

From : Commtech Asia (Thailand)

By :

Name / Position ( )

Date :

Reviewed By : Tarkoon Suwansukhum  
AURECON

Name / Position ( Tarkoon S / Architect )

Date : 10 February 2026

(4) ATTN : STT GDC

☐ Clarification only ☐ Not Approved

☐ Approved for proceeding work

☐ Approved with comments, proceeding work in compliance with comments

☐ Approved with comments, not for proceeding work and need to re-submit

Note :

From : AURECON

By :

Name / Position ( )

Date :

Reviewed By : STT GDC

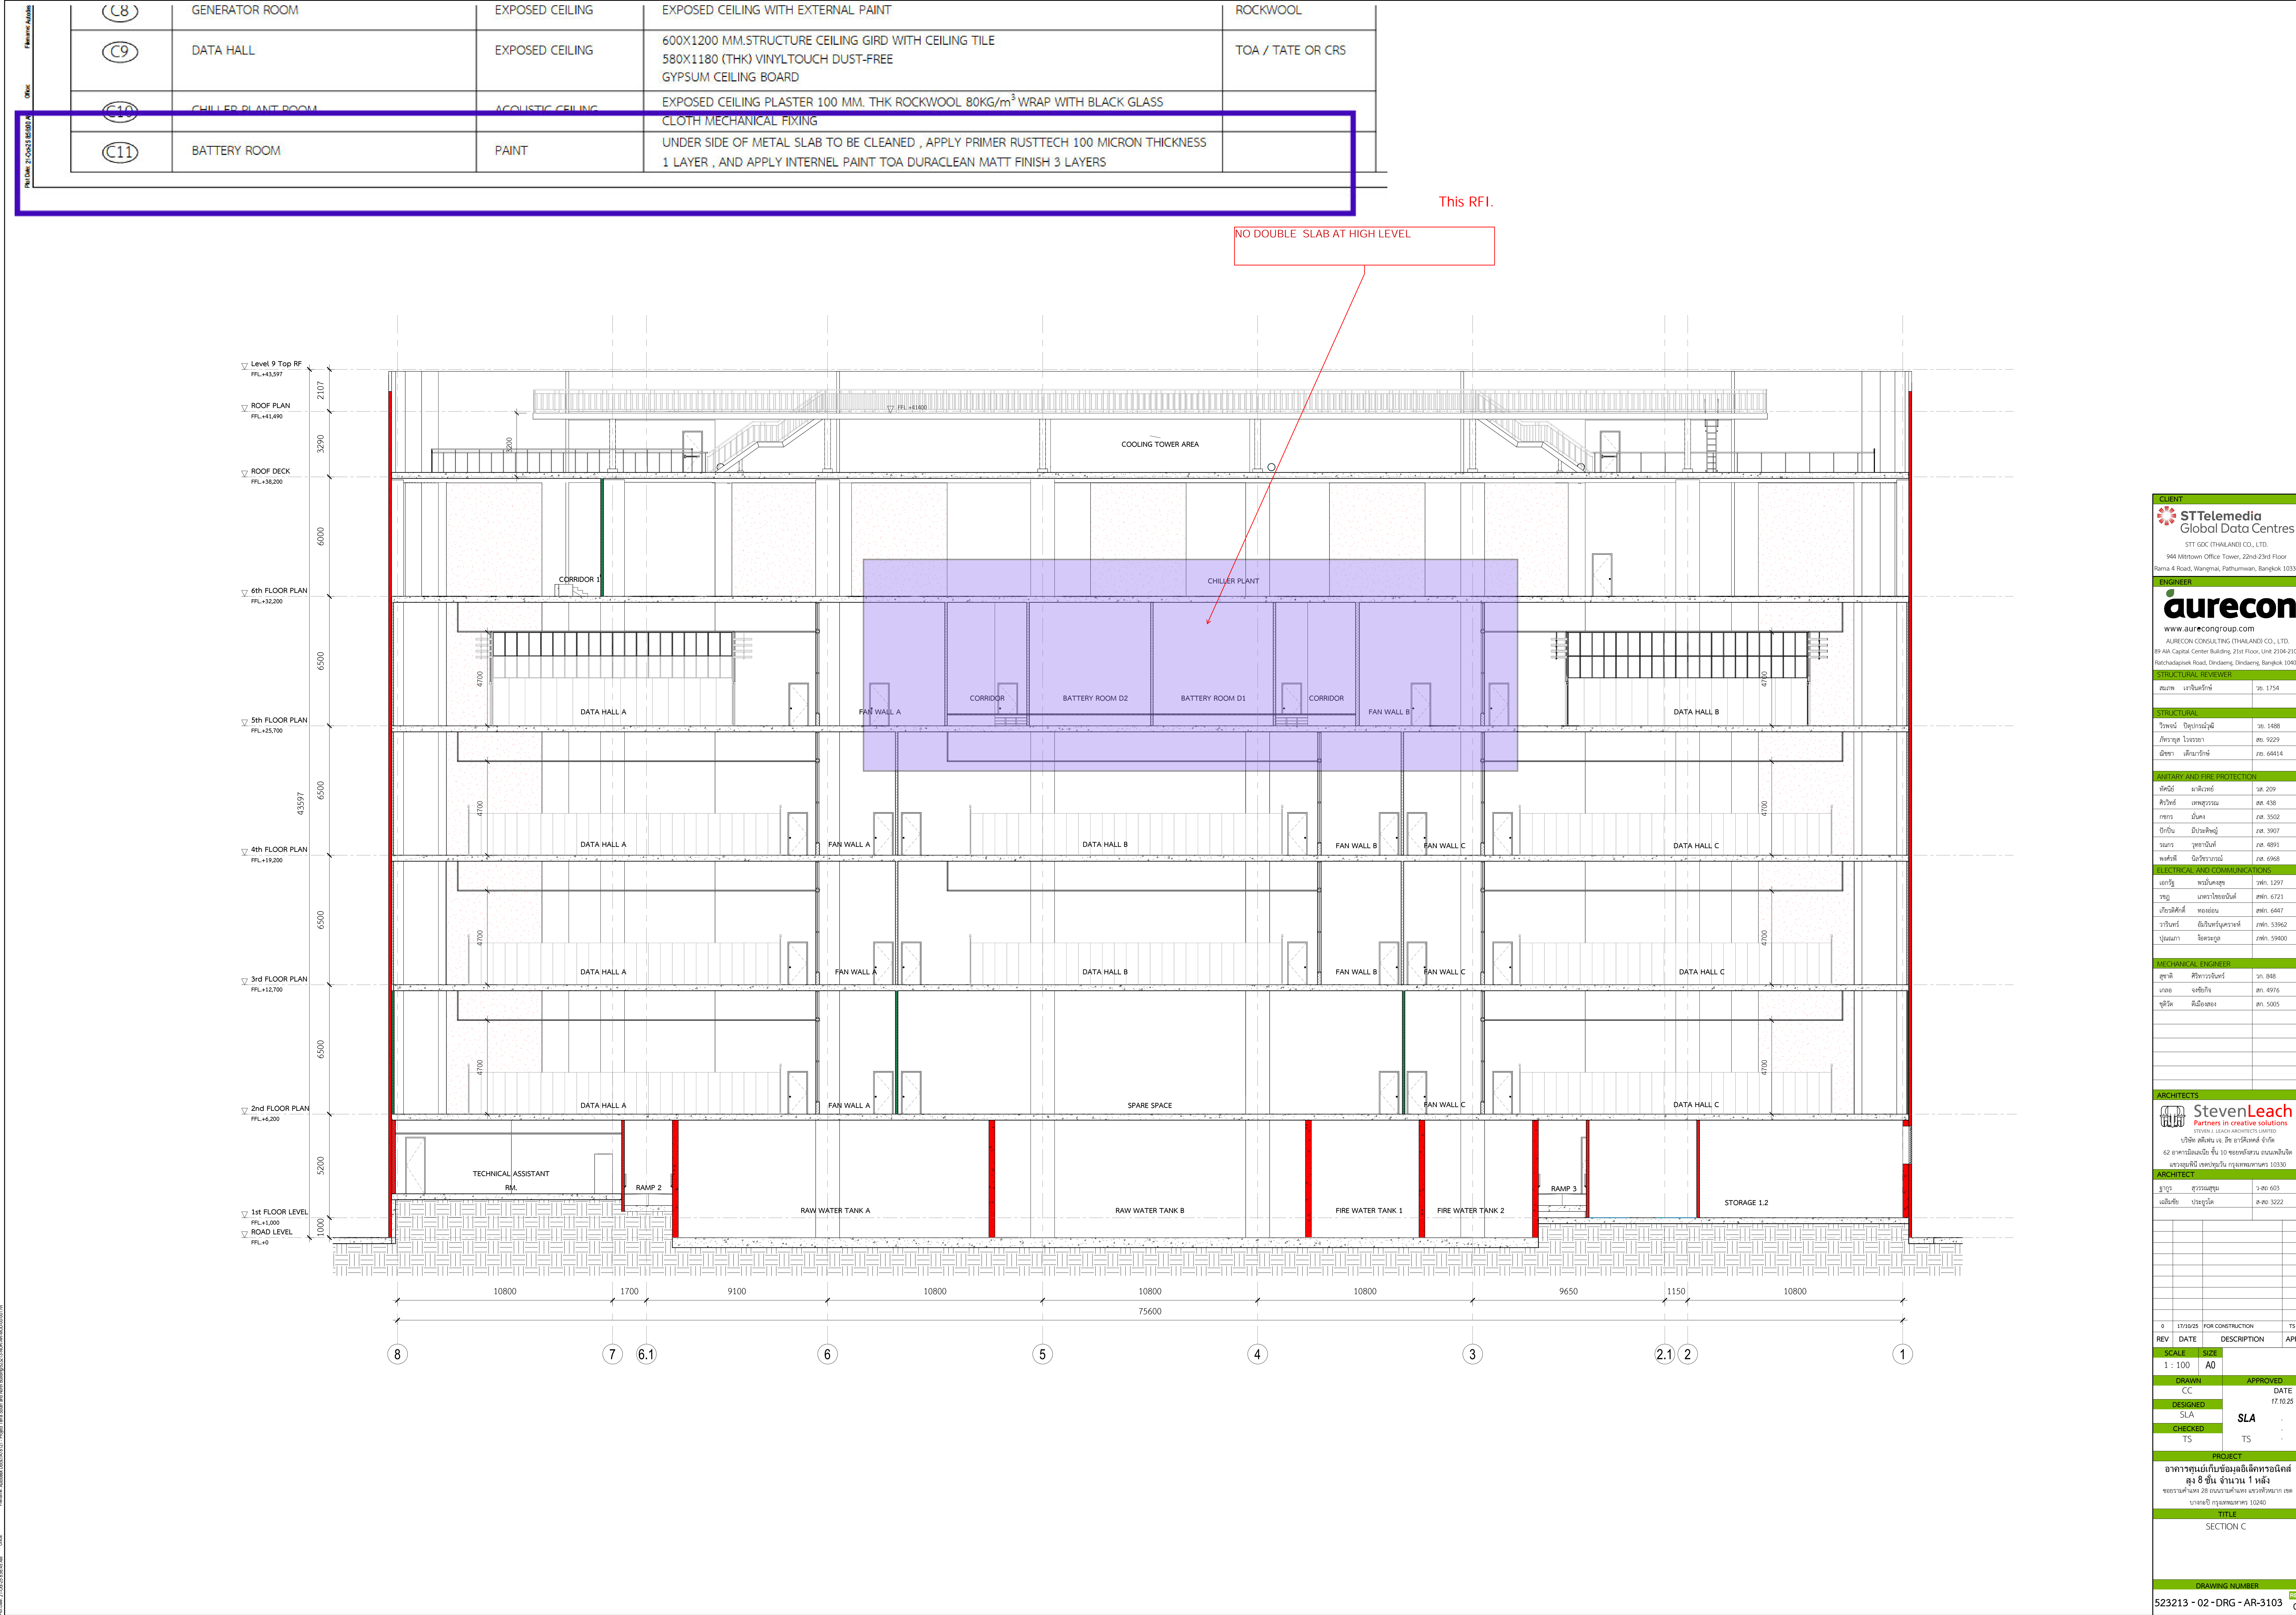
Name / Position

Date :









CLIENT

**STTelemedia**  
Global Data Centres

STT GDC (THAILAND) CO., LTD.  
944 Mitotown Office Tower, 22nd-23rd Floor  
Rama 4 Road, Wangmai, Pathumwan, Bangkok 10330

ENGINEER

**aurecon**  
www.aurecongroup.com  
AURECON CONSULTING (THAILAND) CO., LTD.  
89 AA Capital Center Building, 21st Floor, Unit 2104-2107  
Ratchadapisek Road, Din Daeng, Bangkok 10400

STRUCTURAL REVIEWER










ARCHITECTS

**StevenLeach**  
Partners in creative solutions  
STEVEN J. LEACH ARCHITECTS LIMITED  
บริษัท สตีเวน เอ. ลีช อาร์ทิสต์ จำกัด  

ARCHITECT


REVISIONS

REV	DATE	DESCRIPTION	APP
0	17/10/25	FOR CONSTRUCTION	TS

SCALE

1 : 100 A0

DRAWN

CC

DESIGNED

SLA

CHECKED

TS

APPROVED

DATE

17.10.25

PROJECT

8 ชั้น จำนวน 1 หลัง  

TITLE

SECTION C

DRAWING NUMBER

523213 - 02 - DRG - AR-3103